CERTIFIED LAND CORNER RESTORATION

Index No. A-3

State of Wisconsin
County of Oneida } ss.

I Philip T. Hansen, do hereby certify that on the 10th day of January, 19 78, I found evidence of the Quarter corner of Section 6 & 31 Township 35 & 36, North, Range 10 East, Fourth Principal Meridian, as described hereon; and that from this evidence I established a new monument and accessories as described hereon to perpetuate the original location of this corner.

Resident witnesses:

Glen Barker

Jim Claflin

Herb Wagoner

WISCONSIN PHILIP T. HANSEN S-498 LAND SURVEYOR

T35N R10E

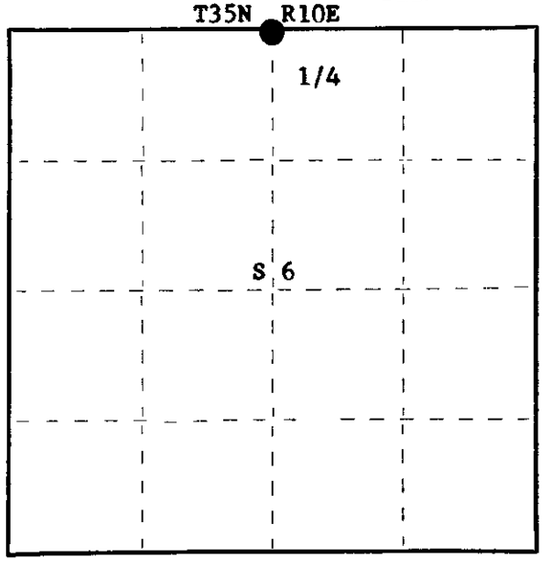

O = Corner monument restored.

History of original corner establishment: Original Corner established by Hiram C. Fellows, Deputy Surveyor, in 1859, from which Aspen 16" bears S20°W, 21 links; Aspen 12" bears N20°W, 25 links.

Corner re-established by N. Loftus, Ripco Surveyor, in 1959. Ran random line east from Section 36, 31, 6 & 1 83.62 chains to close out 3.13 chains south of Section Corner 31, 32, 5 & 6. Corrected bearing S 88° 39' E.

Set corner by proportional measurement at 42.53 chains, 1.592 chains north.

Marked NBT's - Red Maple 4" N73°W, 61½ links
Balsam 5" S61°E, 65 links

Description of corner evidence found:

Searched but was unable to recover corner monument.

Recovered OBT's - Maple 4" (6") N73°W, 61.5 links, scribing partly visible.
Balsam 5" (9") S61°E, 65 links, scribing partly visible.

Determined location of corner by intersection of arcs from BT's.

Description of monument and accessories I established to perpetuate the original location of this corner.

Set 2½" iron pipe with brass cap for corner. Monument projects 24" above ground. Cap stamped S498

Marked NBT's - Sugar 8" N84°W, 76.3 links
Sugar 9" S10°W, 82.8 links
Sugar 7" S24°E, 93.4 links,
all scribed 1/4 BT.

Corner sets on the south end of a small clearing, two chains north of an old woods road.

T36N R10E
1/4 S 31 / S 6
T35N R10E

Dated at Rhinelander, Wis., this 12th day of January, 19 78.

Signature Philip T. Hansen Title Registered Land Surveyor Registration No. S-498
(County Surveyor, Registered Land Surveyor, or other duly authorized official)

Office of Register of Deeds, County of Oneida, I hereby certify that the within instrument was filed in this office for record on the 30th day of January, 1978 at 1:45 o'clock P. M.

Doris Verage Kuehn
(Register of Deeds)

By ..... Deputy

FORM 985 H. C. MILLER CO., MILWAUKEE

36103100020