
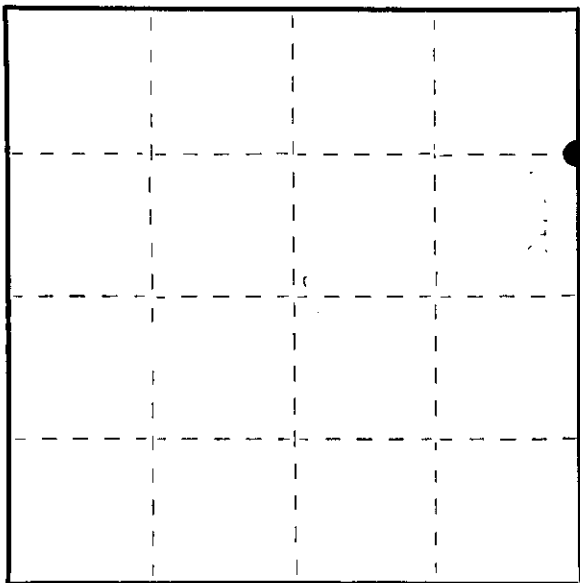


State of Wisconsin

County of \_\_\_\_\_ } ss.

I, \_\_\_\_\_, do hereby certify that on the \_\_\_\_\_ day of \_\_\_\_\_, 19\_\_\_\_, I found evidence of the \_\_\_\_\_ corner of \_\_\_\_\_ Township \_\_\_\_\_ North, Range \_\_\_\_\_ Fourth Principal Meridian, as described hereon; and that from this evidence I established a new monument and accessories as described hereon to perpetuate the original location of this corner.

Resident witnesses:

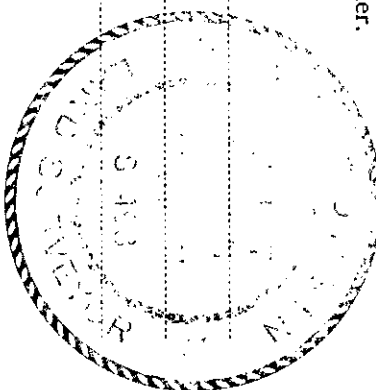

○ = Corner monument restored.

History of original corner establishment:

\_\_\_\_\_

Description of corner evidence found:

\_\_\_\_\_

Description of monument and accessories I established to perpetuate the original location of this corner.

\_\_\_\_\_

Dated at \_\_\_\_\_ Wis., this \_\_\_\_\_ day of \_\_\_\_\_, 19\_\_\_\_

Signature: Philip D. Johnson Title: \_\_\_\_\_ Registration No. \_\_\_\_\_  
(County Surveyor, Registered Land Surveyor, or other duly authorized official)

Office of Register of Deeds, County of \_\_\_\_\_  
Instrument was filed in this office for record on the \_\_\_\_\_ day of \_\_\_\_\_, 19\_\_\_\_  
at \_\_\_\_\_ o'clock \_\_\_\_\_ M.

Signature: James H. [unclear]  
(Register of Deeds)

By \_\_\_\_\_ Deputy

3610310030