

CERTIFIED LAND CORNER RESTORATION

Index No. Y-5



State of Wisconsin

County of Oneida } ss.

I, Phillip T. Hansen, do hereby certify that on the 10th day of August, 1979, I found evidence of the S 1/16 corner of Sections 31 and 32 Township 36 North, Range 10 East, Fourth Principal Meridian, as described hereon; and that from this evidence I established a new monument and accessories as described hereon to perpetuate the original location of this corner.

Resident witnesses:

- Glen Barker
Jim Claffin
Herb Wagoner

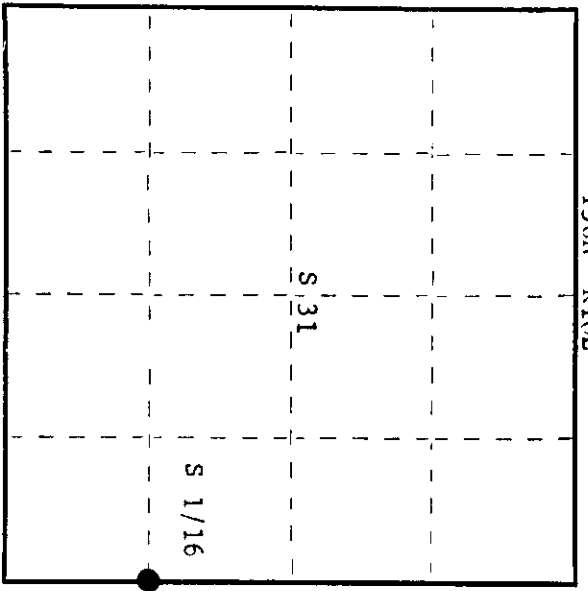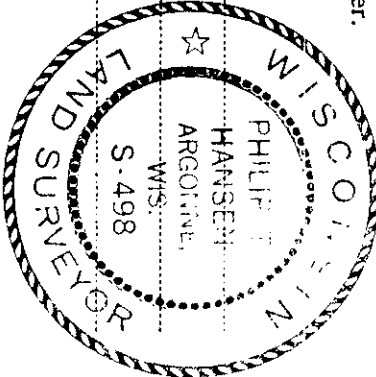

O = Corner monument restored.

History of original corner establishment:

Corner established by Goddard and crew, Ripco surveyors, in 1959. Ran random line south from section corner 29, 32, 31, 30, magnetic bearing 176° 15 magnetic to close out 7.64 chains west of section corner 31, 32, 5 and 6. Re-established 1/4 corner and set S 1/16 corner intermediate. Set wood post and marked BT's - Balsam 6" N2°E 41 links Balsam 6" S79°E 67 links

Description of corner evidence found:

Recovered the post hole and a piece of the old point. Recovered OBT's - Balsam 6" (10") N2°E 41 links, scribed S 1/16 S32 BT and Balsam 6" (10") S79°E 67 links, scribing partly visible.

Description of monument and accessories I established to perpetuate the original location of this corner.

- Replaced old point with 1-1/2" iron pipe with 2" brass cap, stamped: Monument projects 24" above ground.
Built rock cairn around base of monument.
Marked NBT's - S498
White Birch 8" S88°E 11 links T36N R10E
Maple 6" 48°W 23.6 links, scribed 1/16 BT. S 1/16 31+32
CPI-1979

Dated at Rhineland, Wis., this 14th day of August, 1979.

Signature: Phillip T. Hansen, Registered Land Surveyor, Oneida. Title: Registered Land Surveyor. Registration No. S-498. Office of Register of Deeds, County of Oneida. I hereby certify that the within instrument was filed in this office for record on the 21st day of August, 1979 at 1:00 o'clock P.M.

Signature: [Deputy Signature], (Register of Deeds)

By: [Signature], Deputy

3610311000