

CERTIFIED LAND CORNER RESTORATION

Index No. Y-3



State of Wisconsin

County of Oneida } ss.

I Philip T. Hansen, do hereby certify that on the 13th day of August, 1979, I found evidence of the SC 1/16 corner of Section 31 Township 36, North, Range 10 East, Fourth Principal Meridian, as described hereon; and that from this evidence I established a new monument and accessories as described hereon to perpetuate the original location of this corner.

Resident witnesses:

Glen Barker  
Jim Clafflin  
Herb Wagoner

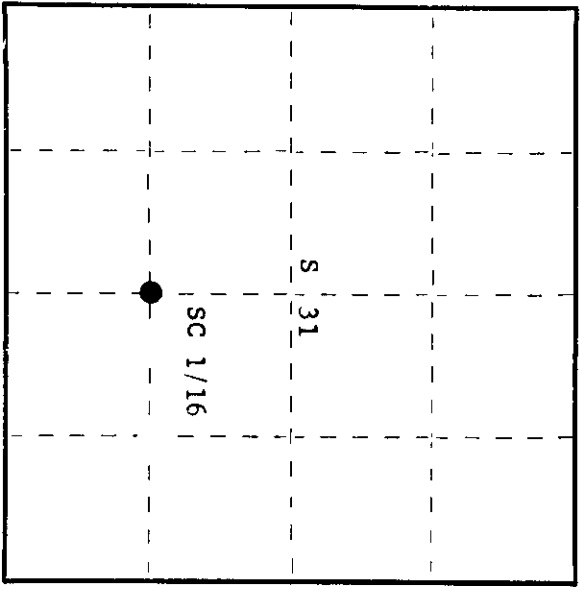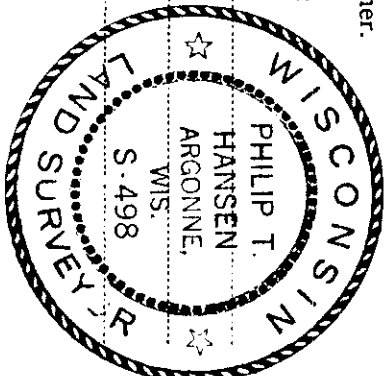

○ = Corner monument restored.

History of original corner establishment:

Corner established by Goddard and crew, Ripco surveyors, in 1959. Ran random line south, bearing 174° 30' magnetic from N 1/4 corner to S 1/4 corner and E-W 1/4 line to establish the C 1/4 corner. Set SC 1/16 corner at 22.39 chains from C 1/4 corner.

Marked BT's -  
Cedar 11° S4°W 32 links  
Cedar 6° S70°W 48 links

Description of corner evidence found:

Recovered a 3" squared and scribed cedar post standing in poor condition.  
Recovered OBT's -  
Cedar 11° S7°W 32 links, scribed SC 1/16 S31 BT (now dead).  
Cedar 6° S70°W 48 links (47.7 links) scribed SC 1/16 BT (now dead).

Description of monument and accessories I established to perpetuate the original location of this corner.  
Replaced cedar post with 1-1/2" iron pipe with 2" brass cap, stamped:  
Monument projects 18" above ground.

Marked NBT's -  
Black Ash 2" S19°W 19.4 links  
Black Ash 7" N86°E 16.3 links  
both scribed 1/16 BT.  
S498  
T36N R10E  
SC 1/16 S31  
CPI-1979

Dated at Rhineland, Wis., this 14th day of August, 1979.

Signature Philip T. Hansen Title Registered Land Surveyor Registration No. S-498  
(County Surveyor, Registered Land Surveyor, or other duly authorized official)  
Office of Register of Deeds, County of Oneida  
at 11:00 o'clock P. M. 3/11 day of August, 1979.  
I hereby certify that the within instrument was filed in this office for record on the 3/11 day of August, 1979.

By: Philip T. Hansen Deputy

3610311020