

CERTIFIED LAND CORNER RESTORATION

Index No. X-5

State of Wisconsin

County of Oneida ss.



I, Phillip T. Hansen, do hereby certify that on the 10th day of August, 1979, I found evidence of the 1/4 corner of Sections 31 and 32 Township 36 North, Range 10 East, Fourth Principal Meridian, as described hereon, and that from this evidence I established a new monument and accessories as described hereon to perpetuate the original location of this corner.

Resident witnesses:

Glen Barker

Jim Claffin

Herb Wagoner

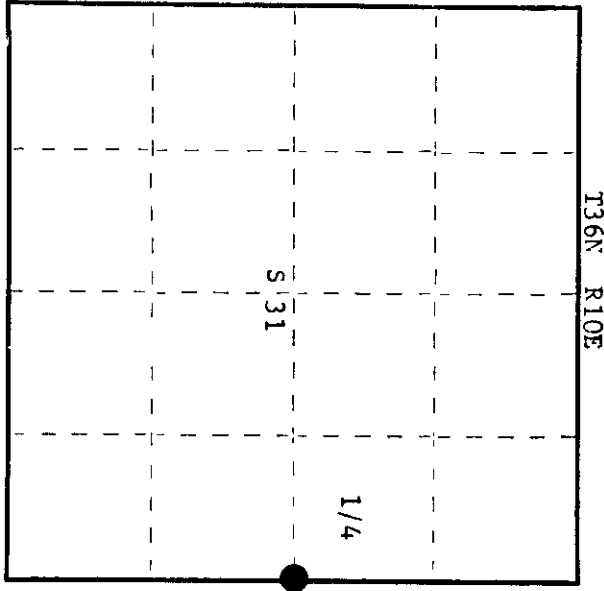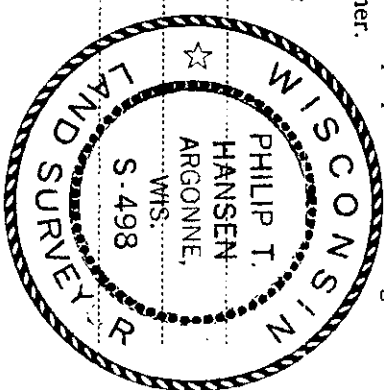

○ = Corner monument restored.

History of original corner establishment: Original corner established by Wm. E. Dougherty, Deputy Surveyor, in 1863 from which Tamarack 8" bears N71°E 10 links and Spruce 8" bears S74°W 10 links.

Corner re-established by Goddard and crew, Ripco surveyors, in 1959. Ran line from section corner 29, 32, 31 and 30, bearing 176° 15' magnetic 9808 chains to close out 7.64 chains west of section corner 32, 5, 6 and 31. Corrected bearing S 5° 43' E. Set 1/4 corner intermediate and marked BT's -

- White Pine 8" S32°W 67-1/2 links
- White Pine 7" S49°E 38 links

Description of corner evidence found:

- Recovered 4" squared cedar post, scribed 1/4 - 1/4, standing in fair condition.
- Recovered ORT's -
- White Pine 8" S32°W 67.5 links, scribed 1/4 S31 T36N R10E (now dead).
- White Pine 7" (10") S49°E 38 links, scribing grown over.

Description of monument and accessories I established to perpetuate the original location of this corner. Replaced post with 2-1/2" Berntsen A-1 Federal Monument, cap stamped: Monument projects 12" above ground.

- Marked NBT's -
- Black Spruce 6" S18°W 45.3 links
- Black Spruce 7" S54°W 57.9 links
- Maple 10" N31°E 49.5 links
- all scribed 1/4 BT.

T36N R10E  
1/4 31+32  
S498-1979

Dated at Rhinelander, Wis., this 14th day of August, 1979.

Signature: *Phillip T. Hansen* Title: Registered Land Surveyor Registration No. S-498  
(County Surveyor, Registered Land Surveyor, or other duly authorized official)

Office of Register of Deeds, County of Oneida  
Instrument was filed in this office for record on the 27th day of August, 1979 at 1:00 o'clock P.M.

Signature: *[Signature]* (Register of Deeds)

By: Deputy

3610312000