

CERTIFIED LAND CORNER RESTORATION

Index No. X-3



State of Wisconsin

County of Oneida } ss.

I Phillip T. Hansen, do hereby certify that on the 8th day of August, 1979, I found evidence of the C 1/4 corner of Section 31 Township 36 North, Range 10 East, Fourth Principal Meridian, as described hereon; and that from this evidence I established a new monument and accessories as described hereon to perpetuate the original location of this corner.

Resident witnesses:

- Glen Barker
Jim Claflin
Herb Wagoner

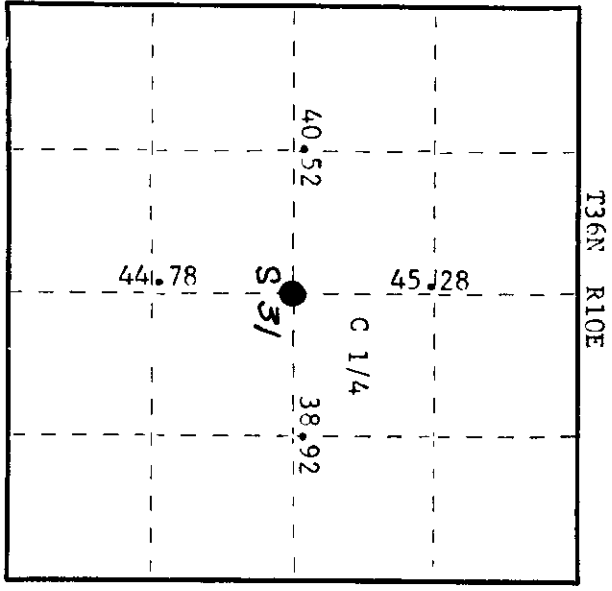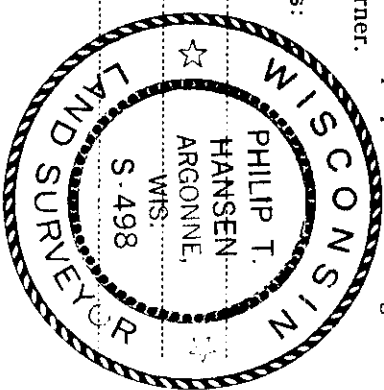

O = Corner monument restored.

History of original corner establishment:

Corner established by Goddard and crew. Ran N-S and E-W 1/4 lines to establish this corner. Set post and marked NBT's - Cedar 9" S70°E 16-1/2 links Cedar 9" N3°E 45-1/2 links

Description of corner evidence found:

Recovered 3" cedar post, squared and scribed C 1/4 - C 1/4, standing in poor condition. Recovered OBT's - Cedar 9" (10") S70°E 16.5 links Cedar 9" (10") N3°E 45.5 links Both scribed C 1/4 S3' T36N R10E

Description of monument and accessories I established to perpetuate the original location of this corner. Replaced post with 2-1/2" Reintsen A-1 Federal Monument, cap stamped:

Monument projects 18" above ground. Marked NBT's - Cedar 8" N64°E 34.4 links Cedar 10" S11°E 50.3 links scribed C 1/4 BT. T36N R10E S 31 S498 - 1979

Dated at Rhinelander, Wis., this 14th day of August, 1979

Signature of Phillip T. Hansen, Registered Land Surveyor, Oneida. Office of Register of Deeds, County of Oneida. I hereby certify that the within instrument was filed in this office for record on the 15th day of August, 1979 at 1:00 o'clock P.M.

By: [Signature] Deputy

3610312020