

CERTIFIED LAND CORNER RESTORATION

Index No. X-2



State of Wisconsin

County of Oneida } ss.

I Philip T. Hansen, do hereby certify that on the 7th day of August, 1979, I found evidence of the WC 1/16 corner of Section 31 Township 36, North, Range 10 East, Fourth Principal Meridian, as described hereon; and that from this evidence I established a new monument and accessories as described hereon to perpetuate the original location of this corner.

Resident witnesses:

Glen Barker
Jim Clafin
Herb Wagoner

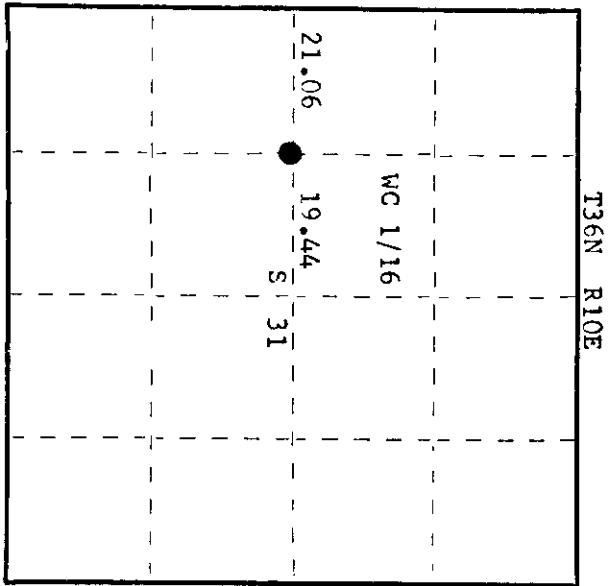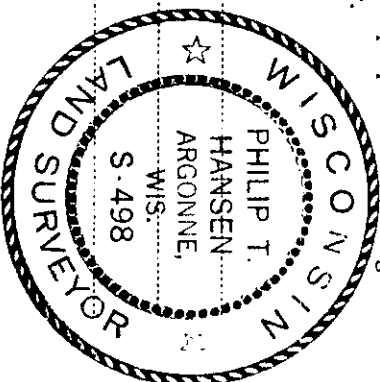

O = Corner monument restored.

History of original corner establishment:

Corner established by N. Loftus, Ripco surveyor, in 1959. Ran the N-S and E-W 1/4 lines to establish the C 1/4 corner. Set the WC 1/16 at 21.06 chains at N 84° 51' E of W 1/4, 19.44 chains S 84° 51' W of C 1/4 corner.

Marked NBT's -
Maple 5" N72°W 12-1/2 links
Maple 5" N67°E 11-1/2 links

Description of corner evidence found:

Recovered post hole and a piece of the old point.
Recovered OBT's -
Maple 5" (7") N72°W 12.5 links
Maple 5" (7") N67°E 11.5 links
scribing on both BT's legible.

Description of monument and accessories I established to perpetuate the original location of this corner.

Set a 1-1/2" iron pipe with 2" brass cap in old post hole. Cap stamped:
Monument projects 24" above ground.
Built a rock cairn around base of monument.
No additional accessories established.

S498
T36N R10E
WC 1/16 S 31
CPI-1979

Dated at Rhinelander, Wis., this 14th day of August, 1979.

Signature: Philip T. Hansen, Registered Land Surveyor, Oneida. Title: Registered Land Surveyor. Office of Register of Deeds, County of Oneida. Instrument was filed in this office for record on the 29th day of August, 1979 at 10:00 o'clock P.M. I hereby certify that the within

By: [Signature] Deputy

3610312030