

CERTIFIED LAND CORNER RESTORATION

Index No. W-5

State of Wisconsin

County of Oneida } ss.


I Phillip T. Hansen, do hereby certify that on the 7th day of August, 19 79, I found evidence of the N 1/16 corner of Section 31 & 32 Township 36, North, Range 10 East, Fourth Principal Meridian, as described hereon; and that from this evidence I established a new monument and accessories as described hereon to perpetuate the original location of this corner.

Resident witnesses:


Glen Barker

Jim Claflin

Herb Wagoner

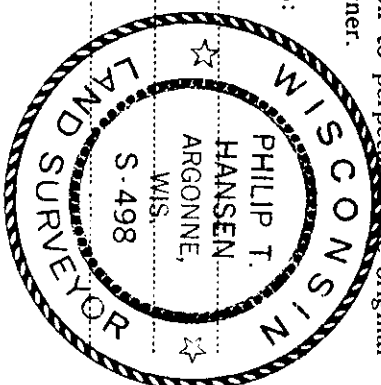

T36N R10E

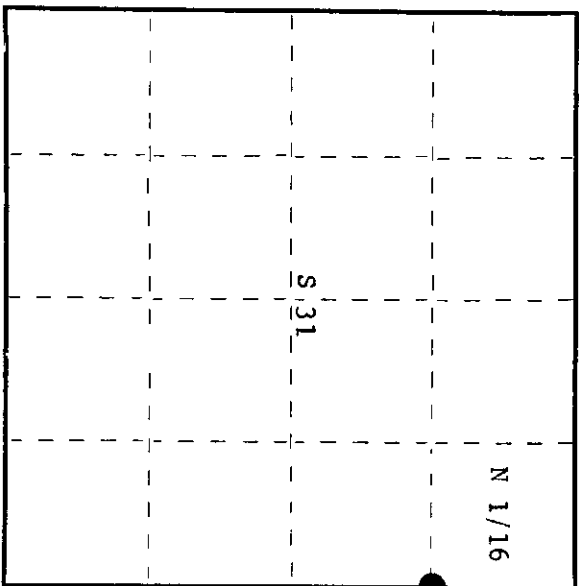

○ = Corner monument restored.

History of original corner establishment:

Corner established by Goddard and crew, Ripco surveyors. Ran random line south from section corner 29, 32, 31 and 30 to section corner 31, 32, 5 and 6 to close out 7.64 chains west of corner. Set N 1/16 at 24.72 chains, 1.91 chains east. Corrected bearing S 5° 43' E. Marked BT's -
 Black Spruce 5" N47°W 5-1/2 links
 Black Spruce 4" N55°E 5 links

3610 W 13000

Description of corner evidence found:

Recovered Ripco's 3" squared tamarack post, scribed N 1/16 S31 N 1/16 S32, standing in poor condition.
 Recovered OBT's -
 Black Spruce 5" N47°W 5.5 links, scribed N 1/16 BT, now a 7' stub.
 Black Spruce 4" (5") N55°E 5 links (5.5 links), scribed N 1/16 BT.

Description of monument and accessories I established to perpetuate the original location of this corner.
 Replaced post with 1-1/2" iron pipe with 2" brass cap, stamped:

S498

T36N R10E

N 1/16 S31 + S32

CPI-1979

Monument projects 18" above ground.

Marked NBT -

Black Spruce 6" S9°E 16.9 links, scribed 1/16 BT.

Dated at Rhineland, Wis., this 14th day of August, 19 79.

Signature: Phillip T. Hansen Title: Registered Land Surveyor Registration No. S-498
 (County Surveyor, Registered Land Surveyor, or other duly authorized official)

Office of Register of Deeds, County of Oneida. I hereby certify that the within instrument was filed in this office for record on the 27th day of August, 19 79 at 1:00 o'clock P.M.

Frank J. Adams
 (Register of Deeds)

By: _____ Deputy