

CERTIFIED LAND CORNER RESTORATION



Index No. **A-7**

State of Wisconsin } ss.  
 County of Oneida

I Phillip T. Hansen, do hereby certify that on the 27th day of June, 1977, I found evidence of the Quarter corner of Section 5 & 32 Township 35 & 36, North, Range 10 East, Fourth Principal Meridian, as described hereon; and that from this evidence I established a new monument and accessories as described hereon to perpetuate the original location of this corner.

Resident witnesses:

Glen Barker  
 Jim Claflin  
 Herb Wagoner

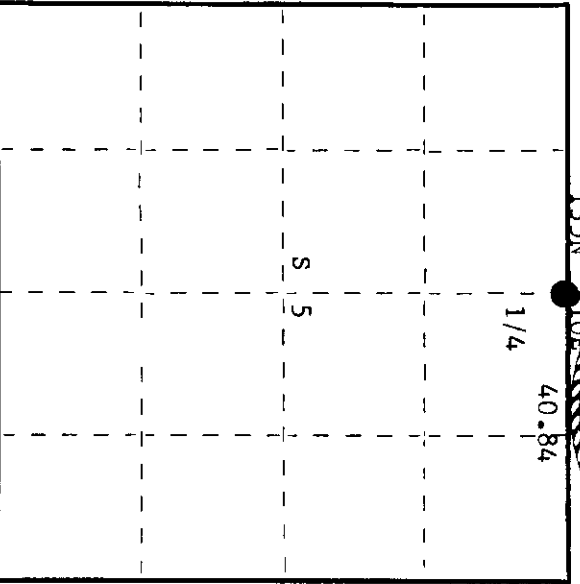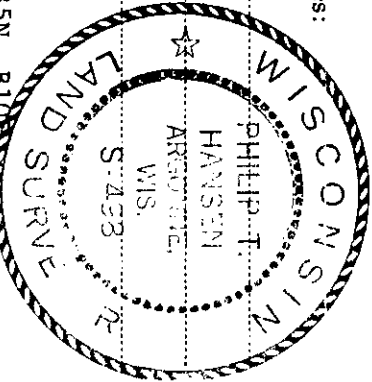

○ = Corner monument restored.

History of original corner establishment:

Original Corner established by Hiram C. Fellows, Deputy Surveyor, in 1859 from which Cedar 14" bears S50°W, 20 links and Cedar 10" bears N5°E, 12 links. H.C. Lawrence, Registered Land Surveyor, recovered original post and cedar 10" N5°E, down and frozen in swamp, in 1947. Corner recovered by N. Loftus, Ripco Surveyor, in 1957 in very poor condition. Set new post and marked NBTs - Cedar 5" N29°E, 19 links and Ash 5" S30°W, 22-3/4 links.

Description of corner evidence found:

Recovered 2 3/4" iron pipe with 4" square brass cap in good condition. Cap stamped: T36N R10E  
 Monument projects 2 feet above ground. 1/4S S/32  
 Also recovered point of old cedar buried in muck. 1/4S S/5  
 Chopped out original cedar 10" N5°E, 12 links, scribe marks 1/4S  
 still visible. Reburied this in muck and water. T35N R10E  
 Recovered - Cedar 7" N29°E, 19 links, scribed 1/4S 32. RIPP  
 Black Ash 5" (7") S30°W, 22-3/4 links, scribing grown over.

Description of monument and accessories: I established to perpetuate the original location of this corner. Monument left in place as recovered. Marked NBT - Cedar 10" S64°E, 37.2 links, scribed 1/4 BT.

Dated at Rhinelander, Wis., this 30th day of June, 1977.  
 Signature Phillip T. Hansen, Title Registered Land Surveyor, Registration No. S-498  
 (County Surveyor, Registered Land Surveyor, or other duly authorized official)  
 Office of Register of Deeds, County of Oneida, I hereby certify that the within instrument was filed in this office for record on the 29th day of July, 1977 at 1:30 o'clock M.

By Joseph M. Boerner Deputy  
Doris Virginia Tuelker  
 (Register of Deeds)

3610320020