
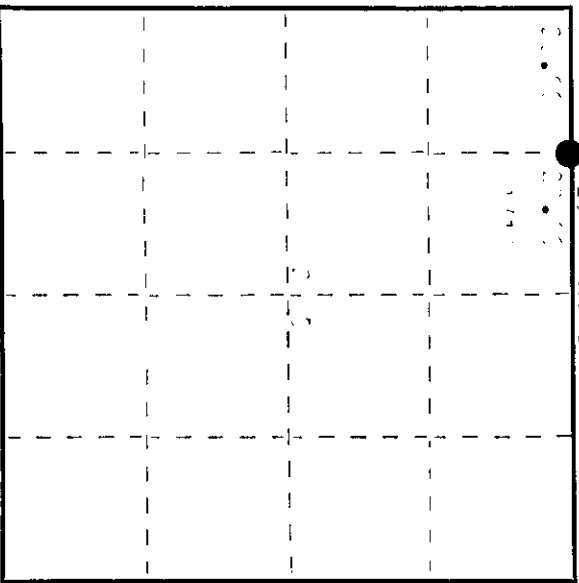


State of Wisconsin



Resident witnesses:

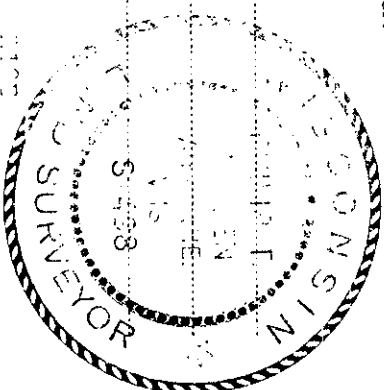

○ = Corner monument restored.

History of original corner establishment:

*[Faint, illegible text describing the history of the original corner establishment.]*

Description of corner evidence found:

*[Faint, illegible text describing the corner evidence found.]*

Description of monument and accessories I established to perpetuate the original location of this corner.

*[Faint, illegible text describing the monument and accessories.]*

Dated at Wausau, Wis., this 11th day of October, 1978.

Signature: John J. Starnes Title: Registered Land Surveyor Registration No. 5458  
(County Surveyor, Registered Land Surveyor, or other duly authorized official)

Instrument was filed in this office for record on the 9th day of January, 1978  
at 2:00 o'clock P. M.

Donna George Kuehn  
(Register of Deeds)

By: Donna George Kuehn Deputy