

CERTIFIED LAND CORNER RESTORATION

Index No. **A-17**

State of Wisconsin

County of Oneida } ss.

I Phillip T. Hansen, do hereby certify that on the 6th day of September, 1978, I found evidence of the Section Corner corner of 34, 35, 2 and 3 Township 36, 35, North, Range 10 East, Fourth Principal Meridian, as described hereon; and that from this evidence I established a new monument and accessories as described hereon to perpetuate the original location of this corner.

Resident witnesses:
Jim Claflin
Herb Wagoner
John Masbaum

History of original corner establishment:

Original corner established by Hiram C. Fellows, Deputy Surveyor, in 1859, from which tamafack 7' bears N 14° W, 18 links; Fir 14" bears N 75° E, 22 links; hemlock 8" bears S 11° E, 18 links and aspen 9" bears S 50° W, 12 links.

H.C. Lawrence recovered an iron pipe and cedar BT's in 1949. No evidence was recovered at this time of any original BT's.
 Ripco surveyors tied into this corner in 1961.


Description of corner evidence found:

Recovered an Oneida County iron monument, not stamped, Ripco's 2" iron pipe with 3" square brass cap and H.C. Lawrence's 5" cedar post scribed S2 T35N S35, T36N S34, R10E - S3.
 Recovered OBT's - cedar 10" S40°E, 41.5 feet, scribing partly legible.
 cedar 10" S63°W, 27.3 links, scribing partly legible.
 cedar 12" S3°W, 10.3 links, axe marks and blazes.

Description of monument and accessories I established to perpetuate the original location of this corner.

Removed H.C. Lawrence's post and county monument. Left Ripco's iron pipe as recovered. Monument projects 28" above ground. Cap stamped:

Marked NBT's - cedar 7" N70°E, 25.7 links T36N R10E
 maple 9" N25°E, 20.1 links, scribed SC BT S34+ S35
 T35N R10E

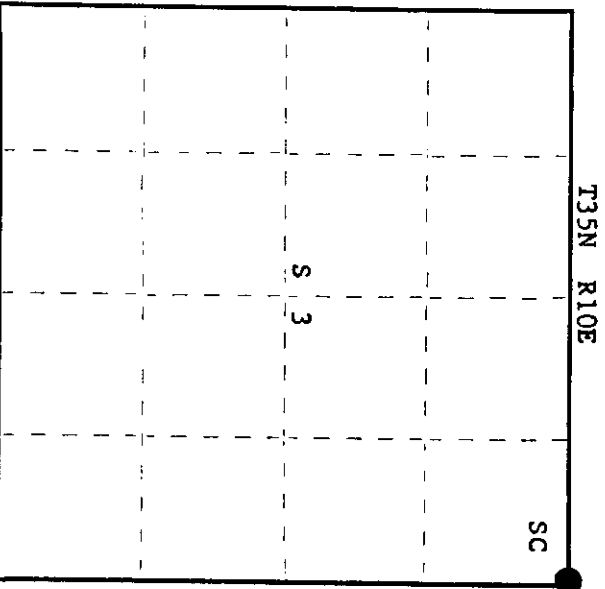

○ = Corner monument restored.

Dated at Rhineland, Wis., this 25th day of September, 1978

Signature: Phillip T. Hansen Title: Registered Land Surveyor Registration No. S-498
 (County Surveyor, Registered Land Surveyor, or other duly authorized official)

Office of Register of Deeds, County of Oneida
 instrument was filed in this office for record on the 9th day of October, 1978
 at 3:30 o'clock P. M.

Dorothy Lange
 (Register of Deeds)

By: _____ Deputy

3610 34000