

At 4:15 O'Clock P.M.  
DORIS VERAGE KUEHN  
REGISTER OF DEEDS

CERTIFIED LAND CORNER RESTORATION  
U. S. PUBLIC LAND SURVEY MONUMENT RECORD

State of Wisconsin }  
County of Oneida } ss.

I JEROME N. KRAEMER, do hereby certify that on the 8th day of April, 1982, I found evidence of the West quarter section corner of Section 35 Township 36 North, Range 10 East, Fourth Principal Meridian, as described hereon; and that from this evidence I established a new monument and accessories as described hereon to perpetuate the original location of this corner:

Description of original monument and accessories and subsequent restorations:

Original Government corner, a Wood Post, was established August 12th, 1863 by D. W. Daugherty, Government Deputy Surveyor  
8" Tamarack N69°E, 13 links  
6" Tamarack S65°W, 30 links

Description of corner evidence found:

Found 1-1/2 inch diameter 4-1/2 foot long iron pipe laying down in wet swamp.  
Found bearing trees: (As measured to new corner)  
9" Tamarack S 4°W, 14.7 feet (old blaze, no scribing, W.C.D. location tag on tree)  
9" Tamarack S10°W, 18.4 feet (old blaze, open, scribed)  
9" Tamarack S65°W, 19.8 feet (old blaze, no scribing orig)  
13" Tamarack N76°E, 20.0 feet (10" high rampike, old blaze no scribing)

I set corner from existing original bearing tree, Tamarack 9" S65°W, 19.8 feet. Position agrees with 1-1/2" iron pipe found laying down.

Description of monument and accessories I established to perpetuate the location of this corner:

April 9th, 1982  
I set a 2" diameter aluminum pipe, 72" long, cone shaped pointed bottom, Berntsen F-1 "Drive-in" cone monument protruding 14" above swamp level with a 3-1/4" diameter cast aluminum cap stamped: ONEIDA COUNTY SURVEY MARKER T36N, R10E, 1/4 S 34, S35, S-1448, 4-9-1982 (the center portion of cap and base contain permanent magnets).


Blazed, scribed and drove P.K. nails in the following trees:

- 6" Tamarack N66°W, 21.60 feet
- 5" Tamarack N25°E, 19.42 feet
- 6" Black Spruce S32°E, 30.90 feet

Compared with all record data & accepted as correct.

*Robert H. Knaack*

Oneida County Surveyor 27 Apr 1983

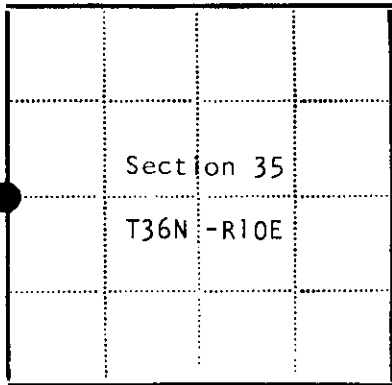

● - Corner monument restored  
□ -

Resident witnesses.....

Dated at Minocqua Wisconsin, this 4th day of January 1983.

Signature *Jerome N. Kraemer* Title Reg. Land Surveyor  
(County Surveyor, Registered Land Surveyor, or other duly authorized official)

Surveyors Registration No. S-1448

Office of..... County of.....

I hereby certify that the within instrument was filed in this office for record on the..... day of..... 19....., and was filed in Book No..... Page No..... of County Records.

Signature..... Title.....

X-17