

CERTIFIED LAND CORNER RESTORATION

Index No. Y-21

State of Wisconsin



County of Oneida } ss.

I, Phillip T. Hansen, do hereby certify that on the 27th day of June, 1979, I found evidence of the S 1/16 corner of Sections 25 & 26 Township 36, North, Range 10 East, Fourth Principal Meridian, as described hereon; and that from this evidence I established a new monument and accessories as described hereon to perpetuate the original location of this corner.

Resident witnesses:

Jim Clafflin

Herb Wagoner

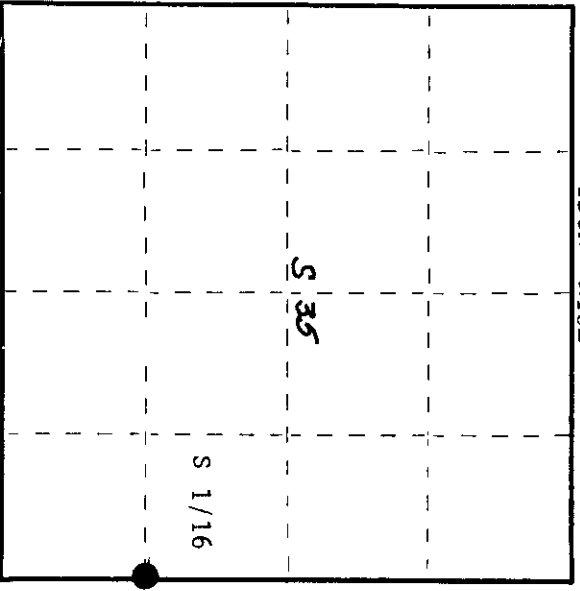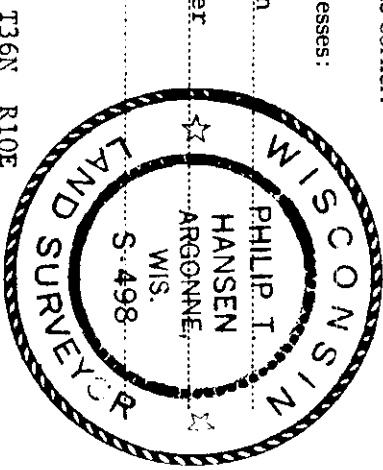

○ = Corner monument restored.

History of original corner establishment:

Corner established by Goddard and crew, Ripco surveyors, in 1960. Ran random line North bearing 351° 48' magnetic, 57.545 chains, to close out 1.237 chains west of W 1/4 corner set by Vaughan and Lawrence. Corrected bearing, N 6° 58' W. Set S 1/16 corner at 28.7725 chains, 61.85 links east.

Marked NBT's -  
Maple 6" S30°W 4 links  
Oak 10" N58°E 49 links

Description of corner evidence found:

Recovered Ripco's 3/4" iron pipe with alloy cap, stamped:  
Monument projects 18" above ground.

Recovered OBT's -  
Maple 6" S30°W (S34°W) 4 links  
Oak 10" (12") N58°E 49 links, scribing grown over.

T36N R10E  
S35 S36  
S 1/16  
RIFCO

Description of monument and accessories I established to perpetuate the original location of this corner.  
Monument left in place as recovered.  
No additional accessories established.

Dated at Rhineland, Wis., this 10th day of July, 1979

Signature Phillip T. Hansen Title Registered Land Surveyor Registration No. S-498  
(County Surveyor, Registered Land Surveyor, or other duly authorized official)

Office of Register of Deeds, County of Oneida, I hereby certify that the within instrument was filed in this office for record on the 7th day of August, 1979 at 1:00 o'clock P.M.

Daniel George Dickson  
(Register of Deeds)

By: \_\_\_\_\_ Deputy

3610351000