

CERTIFIED LAND CORNER RESTORATION



Index No. X-20

State of Wisconsin

County of Oneida } ss.

I, Phillip T. Hansen, do hereby certify that on the 27th day of June, 1979, I found evidence of the EC 1/16 corner of Section 35 Township 36 North, Range 10 East, Fourth Principal Meridian, as described hereon; and that from this evidence I established a new monument and accessories as described hereon to perpetuate the original location of this corner.

Resident witnesses:
Jim Clafflin
Herb Wagoner

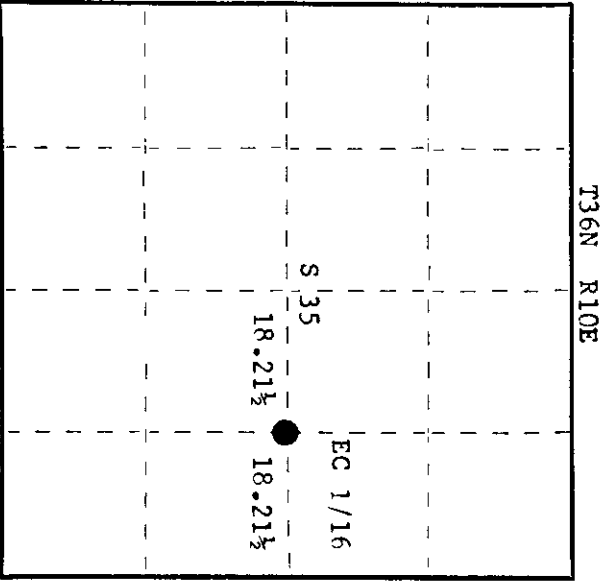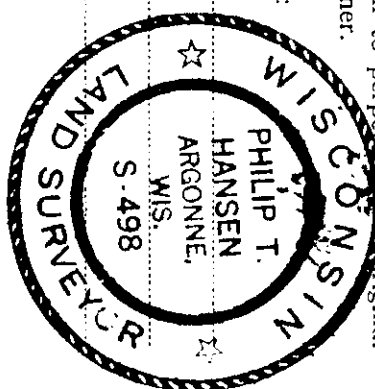

○ = Corner monument restored.

CERTIFIED LAND CORNER RESTORATION

History of original corner establishment:

Corner established by Goddard and crew, Ripco surveyors, in 1960. Ran east-west and north-south 1/4 lines to establish the C 1/4 corner. Corrected bearing of E-W 1/4 line is S 89° 54' W. Set EC 1/16 at 18.21-1/2 links intermediate between E 1/4 and C 1/4 corner.

Marked NBT's -
Cedar 6" N18°W 36 links
Cedar 5" N68°E 17-1/4 links

Description of corner evidence found:

Recovered Ripco's 3/4" iron pipe with alloy cap, stamped:
Monument projects 24" above ground.
Rock cairn around base of monument.
Recovered OBT's -
Cedar 6" (8") N18°W 36 links, scribed CE 1/16 BT.
Cedar 5" (8") N68°E 17-1/4 links, scribed CE 1/16 BT.

Description of monument and accessories I established to perpetuate the original location of this corner.
Monument left in place as recovered.
No additional accessories established.

Dated at Rhinelander, Wis., this 10th day of July, 1979.

Signature: *Phillip T. Hansen* Title: Registered Land Surveyor Registration No. S-498
(County Surveyor, Registered Land Surveyor, or other duly authorized official)

Office of Register of Deeds, County of Oneida, I hereby certify that the within instrument was filed in this office for record on the 7th day of August, 1979, at 1:00 o'clock P.M.

Dorcas Verage Fischer
(Register of Deeds)

By: _____ Deputy

3610352010