

CERTIFIED LAND CORNER RESTORATION

Index No. **A-24**

State of Wisconsin


County of Oneida } ss.

History of original corner establishment:

Corner established by Fred. Lawrence, registered L.M. Surveyor, in 1949. A random line of 88° 33' W, 46.20 chains to close out with chains north of 1/4 corner. Set 4" cedar post at 20.10 chains, 1.07 chains south. No suitable crosses near for I.R.s.

Description of corner evidence found:

Recovered 2" cedar post, squared and scribed 1/16", 2 1/2" dia in four directions. No other corner evidence recovered. No other crosses recovered.

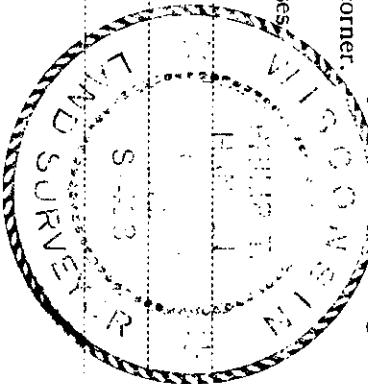


I, William P. Jansen, do hereby certify that on the 24th day of May, 1975, I found evidence of the 1/16 corner of section 1 and 36 Township 35 and 36, North, Range 10, East, Fourth Principal Meridian, as described hereon; and that from this evidence I established a new monument and accessories as described hereon to perpetuate the original location of this corner.

Resident witnesses:

Stan Becker

Jim Claffier

Herb Johnson

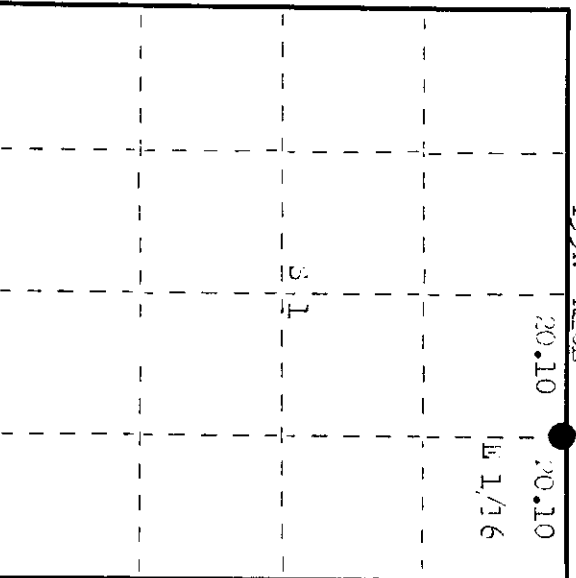

○ = Corner monument restored.

Description of monument and accessories I established to perpetuate the original location of this corner.

replaced cedar post with 1 1/2" dia iron pipe with brass cap at top; set monument projects 10" above ground. Placed rock cairn around base of monument. I.R. - Cedar 3" x 78" x 3.1 links, scribed 1/16". Cedar 2" x 42" x 3.1 links, scribed 1/16 ET.
 2498
 T36N R10E
 2136
 31
 1/16
 T35N R10E
 311-1975

Dated at Wisconsin, Wis., this 23rd day of September, 1975.

Signature: Philip J. Jansen, Title: Registered Land Surveyor, Registration No. 2498 (County Surveyor, Registered Land Surveyor, or other duly authorized official)

Office of Register of Deeds, County of Oneida. I hereby certify that the within instrument was filed in this office for record on the 24th day of November, 1975 at 10:30 o'clock A. M.

Gene George Pascha (Register of Deeds)

By: _____ Deputy