

CERTIFIED LAND CORNER RESTORATION



Index No. **A-23**

State of Wisconsin } ss.
 County of Oneida }

I Phillip T. Hansen, do hereby certify that on the 13th day of May, 1976, I found evidence of the quarter corner of Section 1 and 36 Township 35 and 36, North, Range 10 East, Fourth Principal Meridian, as described hereon; and that from this evidence I established a new monument and accessories as described hereon to perpetuate the original location of this corner.

Resident witnesses.

Glen Barker
 Jim Claflin
 Herb Wagoner

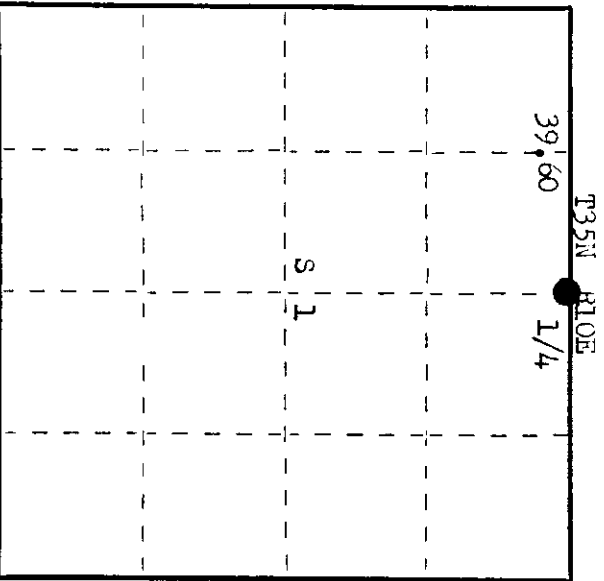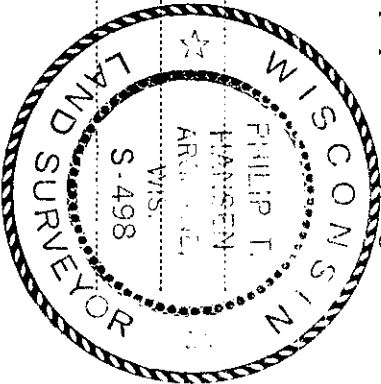

○ = Corner monument restored.

CERTIFIED LAND CORNER RESTORATION

History of original corner establishment: Original Corner established by Hiram C. Fellows, Deputy Surveyor, in 1859, from which pine 10" bears N 30° W 15 lks and spruce 8" bears S 10° W 10 lks.

H.C. Lawrence, registered Land Surveyor, recovered this corner in 1949. Recovered pine stump (original) with scribe marks visible. The blaze on BT appeared to be facing S 30° W instead of S 30° E.

Someone had set an iron pipe for corner at S 30° E 15 lks. Set a new 5" cedar post and marked NBT - Maple 5" N 32° W 31 lks.

Description of corner evidence found: Recovered 5" cedar post, squared and scribed 1/4x3/4, 1/4x3/6, in poor condition, setting beside 2 1/2" iron pipe with brass cap, not scribed. Recovered Maple 5" (8") N 32° W 31 lks, scribing grown over. Original pine stump now decayed. No scribing visible.

Description of monument and accessories I established to perpetuate the original location of this corner. Extracted the iron pipe and wood post from ground and reset iron pipe.

Built a rock cairn around base of pipe. Cap stamped. Marked NBT - Maple 1 1/4" N 54° W 99.2 lks, scribed 1/4 BT. No other trees available for BTs. Monument and BTs painted blue. Monument projects 2 ft. above ground.

S498
 T36N R10E
 1/4 S 1
 T35N R10E
 CPL-1976

Dated at Rhinelander, Wis., this 3rd day of August, 1976.

Signature: *Phillip T. Hansen* Title: Registered Land Surveyor Registration No. S-498
 (County Surveyor, Registered Land Surveyor, or other duly authorized official)

Office of Register of Deeds, County of Oneida. I hereby certify that the within instrument was filed in this office for record on the 22nd day of September, 1976, at 1:00 o'clock P.M.

Terese M. Kishner
 (Register of Deeds)

By: _____ Deputy

3610360020