

CERTIFIED LAND CORNER RESTORATION



Index No. **Y-25**

State of Wisconsin



Resident witnesses:

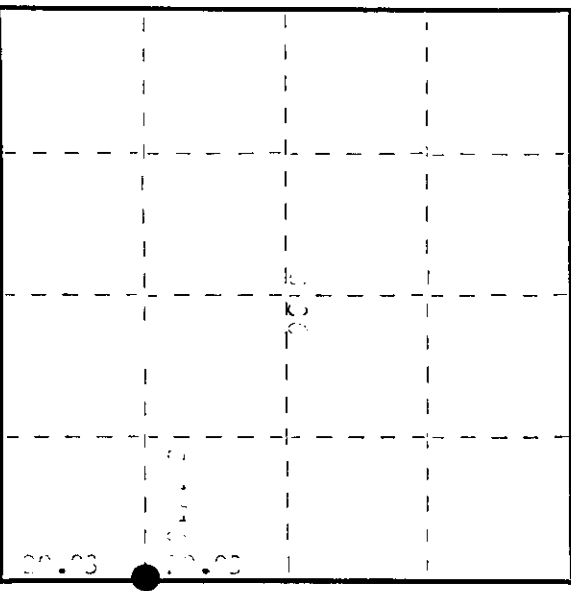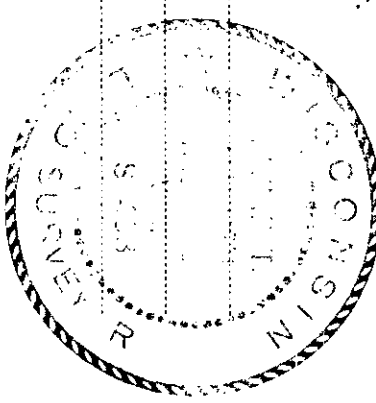

○ = Corner monument restored.

History of original corner establishment:

*[Faint, mostly illegible text describing the history of the original corner establishment.]*

Description of corner evidence found:

*[Faint, mostly illegible text describing the corner evidence found.]*

Description of monument and accessories I established to perpetuate the original location of this corner.







3610361000