

CERTIFIED LAND CORNER RESTORATION

Index No. **X-25**

State of Wisconsin

County of Oneida } ss.

I Phillip T. Hansen, do hereby certify that on the 11th day of January, 19 78, I found evidence of the Quarter corner of Section 36 - 31 Township 36, North, Range 10 & 11 East, Fourth Principal Meridian,



as described hereon; and that from this evidence I established a new monument and accessories as described hereon to perpetuate the original location of this corner.

Resident witnesses:

Glen Barker

Jim Clafflin

Herb Wagoner

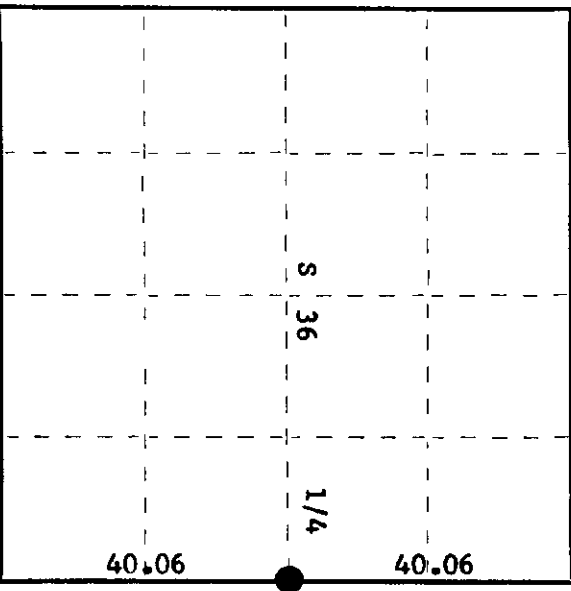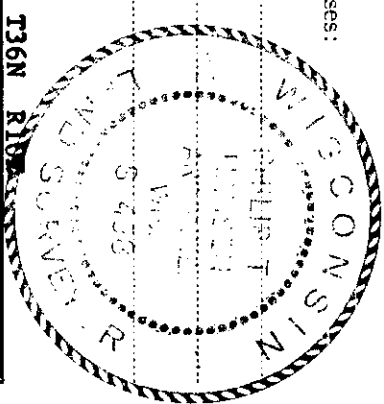

○ = Corner monument restored.

History of original corner establishment:

Original corner established by Hiram C. Fellows, Deputy Surveyor, in 1859, from which Alder 6" bears N61°W, 15 links and Alder 6" bears S66°E, 9 links. Corner recovered by D.H. Vaughan. Set Cedar 10" S76°W, 32 links and Cedar 10" S21°E, 17 links.

H.C. Lawrence, Registered Land Surveyor, ran a random line S10°E from Section Corner 25, 30, 31, 36 a distance of 80.30 chains to close out 2.06 chains east of Township Corner. Established 1/4 corner at 40.03 chains, 103 links west. Marked Cedar 12" N55°W, 20 1/2 links; Cedar 16" S25°E, 43 1/2 links.

Description of corner evidence found:

Recovered Lawrence's 4" cedar post, squared and scribed 1/4S S36, R10E, S31 R11E T36N in fair condition.

Recovered Vaughan's cedar 10" S76°W, 32 links; Cedar 10" S21° 30' E, 17 links, both badly decayed.

Recovered H.C. Lawrence's Cedar 12" (18") N55°W, 20.5 links, scribed 1/4 BT. Cedar 16" S25°E, 43.5 links, now a 5' stub, scribing BT visible.

Description of monument and accessories I established to perpetuate the original location of this corner.

Replaced 4" post with 2 1/2" Berntsen A-1 Federal Monument, aluminum with magnet in cap and base, projecting 12" above ground. Cap stamped:

Marked NBT - Black Spruce 6" S68°W, 65.4 links

Cedar 12" N10°E, 46.0 links

White Birch 10" N75°E, 64.7 links, all scribed 1/4 BT.

Corner sets at the south end of a beaver flowage.

S498
R T36N
10 1/4 S36 + S31 R
E E 11 E

Dated at Rhinelander, Wis., this 12th day of January, 1978

Signature Phillip T. Hansen Title Registered Land Surveyor Registration No. S-498
(County Surveyor, Registered Land Surveyor, or other duly authorized official)

Office of Register of Deeds, County of Oneida, Thereby certify that the within instrument was filed in this office for record on the 30th day of January, 1978 at 1:45 o'clock P. M.

Dorcas Verneke Trueman
(Register of Deeds)

By _____ Deputy

3610362000