



CERTIFIED LAND CORNER RESTORATION

Index No. **E-25**

State of Wisconsin } ss.  
 County of Oneida

I Philip T. Hansen, do hereby certify that on the 16th day of December, 1974, I found evidence of the section corner of 1-12-6-7 Township 36, North, Range 11 and 12 E, Fourth Principal Meridian, as described hereon; and that from this evidence I established a new monument and accessories as described hereon to perpetuate the original location of this corner.

Resident witnesses:

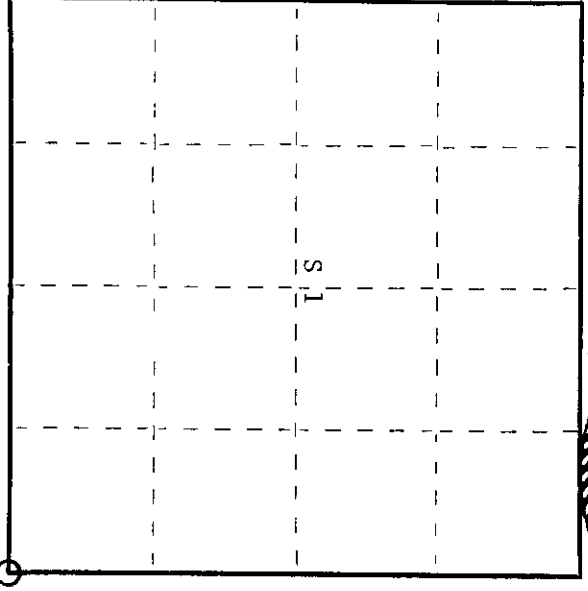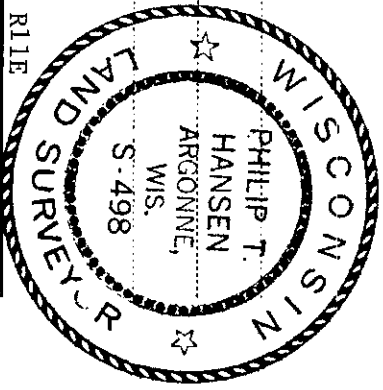

O = Corner monument restored.

History of original corner establishment:  
 Original corner established by Wm. E. Dougherty in 1859.

- White birch 10" N45E 30 links
  - Hemlock 10" N65W 32 links
  - Sugar 10" S15W 2 links
  - White birch 10" S28E 20 links
- B.F. Dorr claims to have recovered the original sugar maple in 1898.
- Hemlock N42W 6 1/2 links
  - Hemlock N78 3/4 E 12 links

H.C. Lawrence recovered Dorr's BT's in 1950 and set a new cedar post from them.  
 Cedar stake N47W 7 1/2 links

Description of corner evidence found:  
 Recovered H.C. Lawrence's cedar post, squared and scribed S1, T36N - S12 R11E, S6, S7, R12E in poor condition. Recovered his cedar stake N47W - 7-1/2 links.

Description of monument and accessories I established to perpetuate the original location of this corner.  
 Set 2-1/2" x 5' galvanized iron pipe with brass cap stamped -

- New BT's - Aspen 7" N22E 14 1/2 links
- White birch 4" S6E 15 1/2 links

R11E T36N S498  
 S1 S6  
 S12 S7  
 CPI-1974

Dated at Rhineland, Wis., this 13th day of January, 1975.

Signature: *Philip T. Hansen* Title: Registered Land Surveyor Registration No. S-498  
 (County Surveyor, Registered Land Surveyor, or other duly authorized official)

Office of Register of Deeds, County of Oneida. I hereby certify that the within instrument was filed in this office for record on the 1st day of October, 1975 at 3:00 o'clock P.M.

*Donna Savage Finkler*  
 (Register of Deeds)

By: \_\_\_\_\_ Deputy

0000010193