

CERTIFIED LAND CORNER RESTORATION



Index No. **E-23**

State of Wisconsin

County of Oneida } ss.

I, Phillip T. Hansen, do hereby certify that on the 12th day of December, 1974, I found evidence of the 1/4 corner of 1 & 12 Township 36, North, Range 11 East, Fourth Principal Meridian, as described hereon; and that from this evidence I established a new monument and accessories as described hereon to perpetuate the original location of this corner.

Resident witnesses:

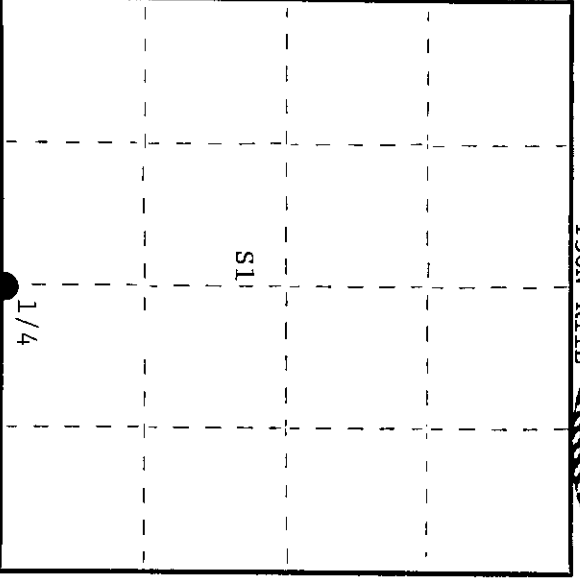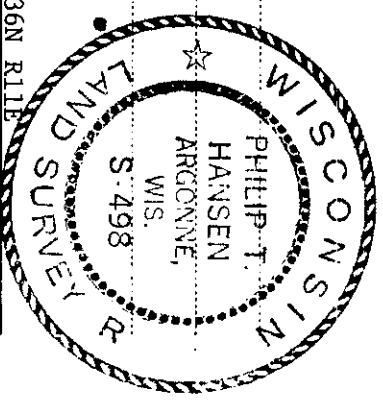

○ = Corner monument restored.

History of original corner establishment:

Original corner established by Wm. E. Dougherty in 1859.
 Birch 12" N18W 26 links
 Sugar 15" S57W 13 links
 Recovered by B.F. Dorr in 1898.
 W. pine stump 22" N20W 15 1/2 links
 H.C. Lawrence set new cedar post at Dorr's 1/4 corner. Squared and scribed S1 1/4-S12 1/4
 Cedar 10" S19W 20 1/2 links

Description of corner evidence found:

Recovered Lawrence 4" cedar post, squared and scribed S1 1/4-S12 1/4 in fair condition.
 Recovered old pine stump, deteriorated N20W - 15 1/2 links.
 Recovered 10" cedar. No top, S26W - 20 links. Scribed 1/4 S12 N.B.T.

Description of monument and accessories I established to perpetuate the original location of this corner.

Set new 2-1/2" x 5' galvanized iron pipe with brass cap.				
Set new B.T.'s	Cedar 8"	N14W	54 links	Scribed 1/4 B.T. S498
	White spruce 5"	S84W	15 1/2 links	Scribed 1/4 B.T. T36N R11E

S1
 1/4
 S12

CPI-1974

Dated at Rhineland, Wis., this 16th day of January, 1974

Signature Phillip T. Hansen Title Registered Land Surveyor Registration No. S-498
 (County Surveyor, Registered Land Surveyor, or other duly authorized official)

Office of Register of Deeds, County of Oneida. I hereby certify that the within instrument was filed in this office for record on the 1st day of October, 1975 at 3:00 o'clock P.M.

Terrie Savage Tuelke
 (Register of Deeds)

By _____ Deputy

3611010020