

CERTIFIED LAND CORNER RESTORATION



Index No. **D-25**

State of Wisconsin

County of Oneida } ss.

I Philip T. Hansen, do hereby certify that on the 10th day of December, 1974, I found evidence of the S-1/16 corner of 1 and 6 Township 36, North, Range 11 and 12 East, Fourth Principal Meridian, as described hereon; and that from this evidence I established a new monument and accessories as described hereon to perpetuate the original location of this corner.

Resident witnesses:

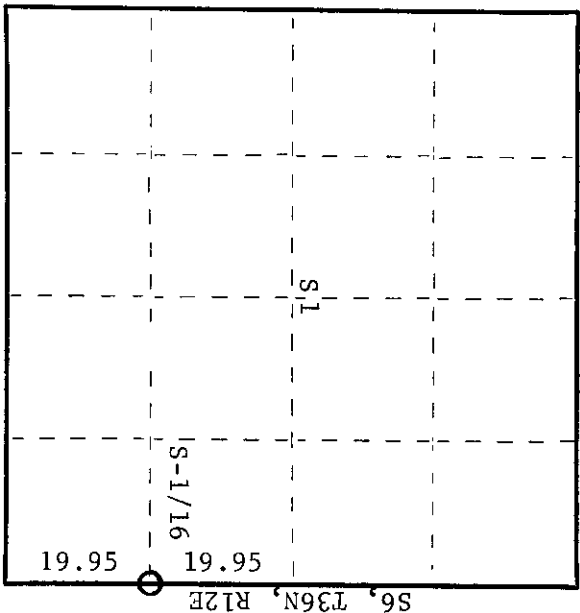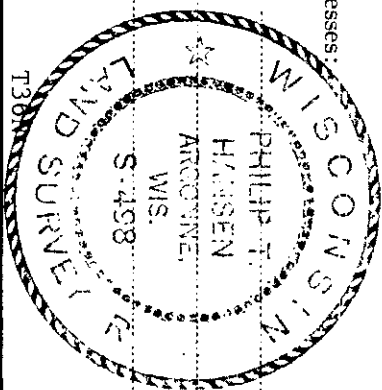

○ = Corner monument restored.

CERTIFIED LAND CORNER RESTORATION

Index No. **D-25**

History of original corner establishment:
H.C. Lawrence recovered an old 1/16 corner of unknown origin when he ran a line from the E-1/4 corner South to the section corner in 1957. The distance between the 1/4 and section corner was 10 links short of the original measurement. Both 1/4 corner and section corner were recovered and checked distances to BT's established by B.F. Dorr's survey of 1898. A new 4" S-1/16 cedar post was set at 19.95 chains, equidistant between the 1/4 corner and the section corner.

NBT's - Yellow birch 20" N87W 53 1/2 links
Sugar maple 11" S18E 28 links

Description of corner evidence found:
Recovered H.C. Lawrence's 4" cedar post, squared and scribed S1-1/16 S6-1/16 in poor condition, tied to a 1" iron pipe.

Recovered old bearing trees - Yellow birch 20" N86°W 53 1/2 links scribed S BT
Sugar maple 11" S17E 27 1/2 links scribed S-1/16

Description of monument and accessories I established to perpetuate the original location of this corner.
Set 1" x 5" iron pipe with 2" brass cap stamped -

No new BT established.

S498
T36N
R11E | S1 | S6
S-1/16 | | R12E
CPI-1974

Dated at Rhinelander, Wis., this 6th day of January, 1975.

Signature *Philip T. Hansen* Title Registered Land Surveyor Registration No. S-498
(County Surveyor, Registered Land Surveyor, or other duly authorized official)
Office of Register of Deeds, County of Oneida
Instrument was filed in this office for record on the 1st day of October, 1975 at 3:00 o'clock P.M.

Jarvis Venage Fuehn
(Register of Deeds)

By Deputy

3611011000