

CERTIFIED LAND CORNER RESTORATION


Index No. B-25

State of Wisconsin


County of Oneida } ss.

I Philip T. Hansen 11th, do hereby certify that on the 11th day of December 19 74, I found evidence of the N-1/16 corner of section 1 and 6 Township 36, North, Range 11 and 12 E, Fourth Principal Meridian, as described hereon; and that from this evidence I established a new monument and accessories as described hereon to perpetuate the original location of this corner.

Resident witnesses:

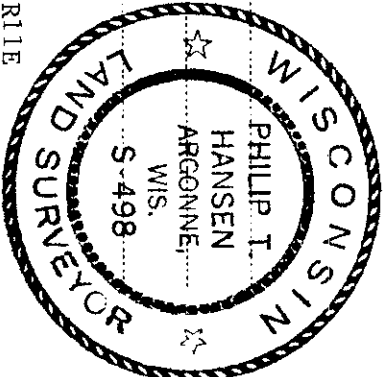

T36N R11E

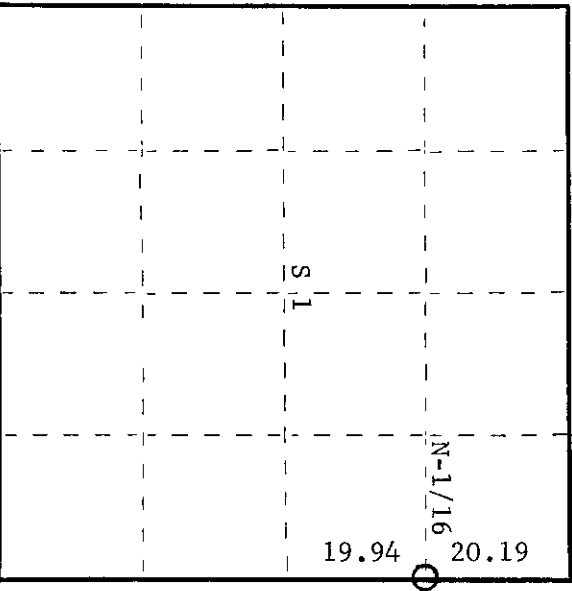

○ = Corner monument restored.

CERTIFIED LAND CORNER RESTORATION

History of original corner establishment:

Original survey established by Wm. E. Dougherty in 1859. Section Corners and 1/4 corner. Retracement survey made by H.C. Lawrence in 1957. His notes indicate he ran a line from corner of Section 1-6-31 and 36 South 1 30' East to 1/4 corner, where he recovered a 4" squared and scribed stake and a bearing tree which checked the original notes. Measurement on this line fell 10 links short of the original. Set new 1/16 corner 21.09 chains south of 1/4 corner and 19.94 chains north of 1/4 corner. BT blazed and scribed.

Description of corner evidence found:

- Recovered BT's - Yellow birch 22" S52E 38 links scribed N 1/16 BT
- Sugar maple 15" South 7 1/2 links
- Yellow birch 20" S48E 37 links
- Sugar 12" S2W 7 links

Recovered 4" cedar post, squared and scribed S1 N 1/16; S6 N 1/16 in good condition. 1" iron pipe set next to this post.

Description of monument and accessories I established to perpetuate the original location of this corner.

- Set 1" x 5" iron pipe with brass cap stamped - S498
- New BT's - Sugar maple 9" N22W 17 links T36N
- Scribed 1/16 BT Scribed 1/16 BT R12E

N 1/16
CPT-1974

Dated at Rhinelander Wis, this 11th day of December 19 74.

Signature *Philip T. Hansen* Title Registered Land Surveyor Registration No. S-498
 (County Surveyor, Registered Land Surveyor, or other duly authorized official)

Office of Register of Deeds, County of Rhinelander Oneida
 Instrument was filed in this office for record on the 1st day of October 19 75
 at 3:00 o'clock P.M.

Doris Venage Bush
 (Register of Deeds)

By _____ Deputy