


CERTIFIED LAND CORNER RESTORATION

Index No. **E-19**

State of Wisconsin


County of Oneida } ss.

I, Philip T. Hansen, do hereby certify that on the 2nd day of January, 1975, I found evidence of the 1/4 corner of Sections 2 and 11 Township 36 North, Range 11 East, Fourth Principal Meridian, as described hereon; and that from this evidence I established a new monument and accessories as described hereon to perpetuate the original location of this corner.

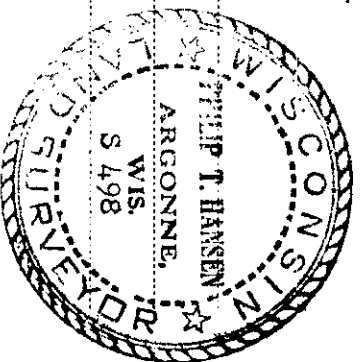

Resident witnesses:

T 36N R11E

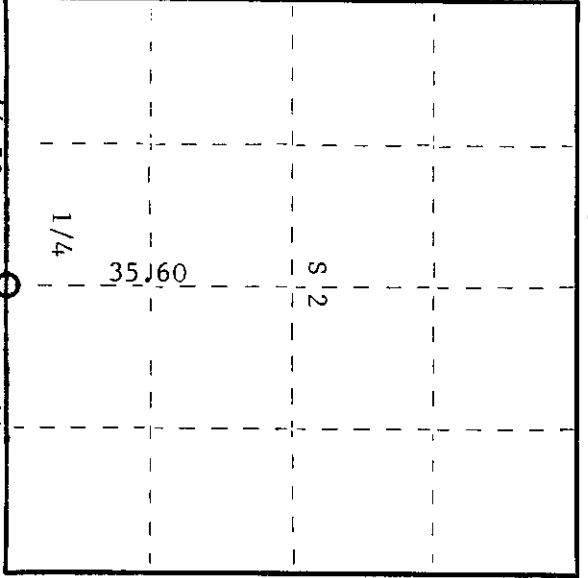

O = Corner monument restored.

CERTIFIED LAND CORNER RESTORATION

History of original corner establishment:

Original corner established by Wm E. Dougherty, Gov. Deputy Surveyor, in 1859. BT's. Tamarack 10" N50E 20 lks. Tamarack 10" S35W 16 lks. Resurvey by B.F. Dorr in 1897, County Surveyor. Replacement survey by H.C. Lawrence, Reg. Land Surveyor, in 1957. He set a new 5" cedar post but did not make any new BT's.

Description of corner evidence found:

Recovered H.C. Lawrence's 4" cedar post, squared and scribed S2 1/4S; SE 1/4S in good condition.

No old bearing trees were recovered.

Description of monument and accessories I established to perpetuate the original location of this corner.

Replaced old wood post with new 2-1/2" x 5' galvanized iron pipe with brass cap stamped -

New BT's. Black spruce 7" S60°W 17-3/4 lks. Scribed 1/4 BT
Black spruce 6" N34E 23-1/4 lks. Scribed 1/4 BT

S 2
1/4
S 11

S498
T36N, R11E
CPI-1975

Dated at Rhineland, Wis., this 2nd day of January, 1975.

Signature *Philip T. Hansen* Title Registered Land Surveyor Registration No. S-498
(County Surveyor, Registered Land Surveyor, or other duly authorized official)

Office of Register of Deeds, County of Oneida. I hereby certify that the within instrument was filed in this office for record on the 1st day of October, 1975 at 3:00 o'clock P.M.

Doris Verage Fuetan
(Register of Deeds)

By: Deputy

3611020020