

CERTIFIED LAND CORNER RESTORATION

Index No. **D-21**


History of original corner establishment:
Original corner established by H.C. Lawrence in 1950. Corner was set equidistant between 1/4 corner and section corner at 21.46 1/2 chains.

White birch 7" S29W 59 1/2 links
White birch 6" N27W 25 links


State of Wisconsin } ss.
County of Oneida }
I, Philip T. Hansen, do hereby certify that on the 10th day of December, 1974, I found evidence of the S-1/16 corner of 1 and 2 Township 36 North, Range 11 East, Fourth Principal Meridian, as described hereon; and that from this evidence I established a new monument and accessories as described hereon to perpetuate the original location of this corner.

Description of corner evidence found:
Recovered 3" spruce post, squared and scribed S1-1/16 S2-1/16 rotted and in poor condition tied to 1" iron pipe set in old posthole.
Recovered old BT's - White birch 14" South 59 links scribed 1/16 White birch 8" N29E 24 links scribed BT

Description of monument and accessories I established to perpetuate the original location of this corner.
Set 1" x 5" iron pipe with 2" brass cap stamped as follows:
No new BT's set.

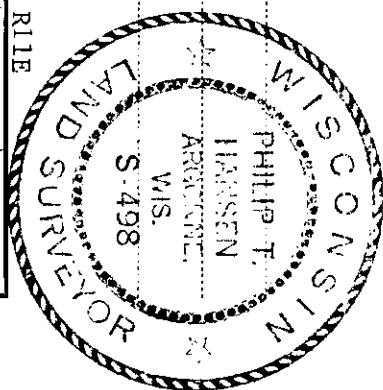

S498
T36N, R11E
S-1/16 S2+S1
CPI-1974

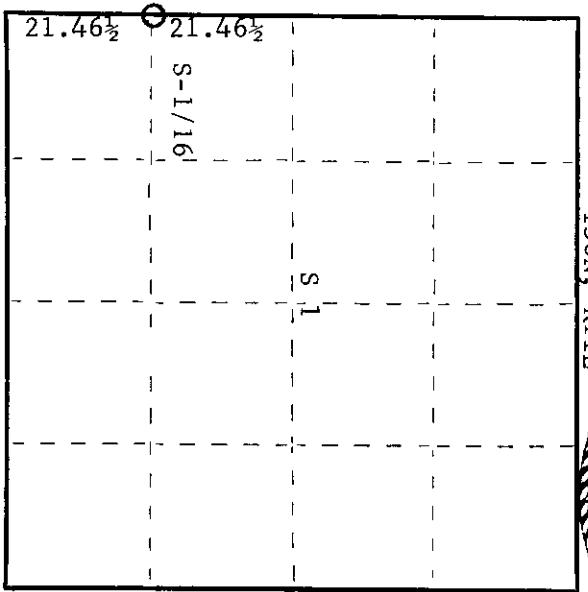

○ = Corner monument restored.

Dated at Rhinelander, Wis., this 4th day of January, 1975

Signature *Philip T. Hansen* Title Registered Land Surveyor Registration No. S-498
(County Surveyor, Registered Land Surveyor, or other duly authorized official)

Office of Register of Deeds, County of Oneida. I hereby certify that the within instrument was filed in this office for record on the 1st day of October, 1975 at 3:00 o'clock P.M.

Doris Verage Fuchsel
(Register of Deeds)

By: Deputy

3611021000