

CERTIFIED LAND CORNER RESTORATION

Index No. **D-19**

State of Wisconsin

County of Oneida } ss.


I Philip T. Hansen, do hereby

certify that on the 11th day of December, 1974, I found


evidence of the SC-1/16 corner of Section 2 Township 36 North, Range 11E

as described hereon; and that from this evidence I established a new monument and accessories as described hereon to perpetuate the original location of this corner.

Resident witnesses:

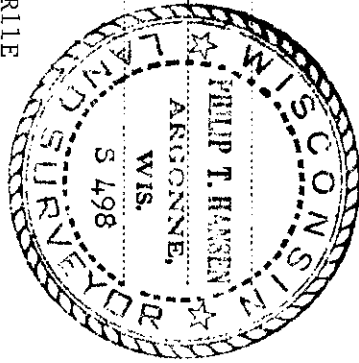

T36N, R11E

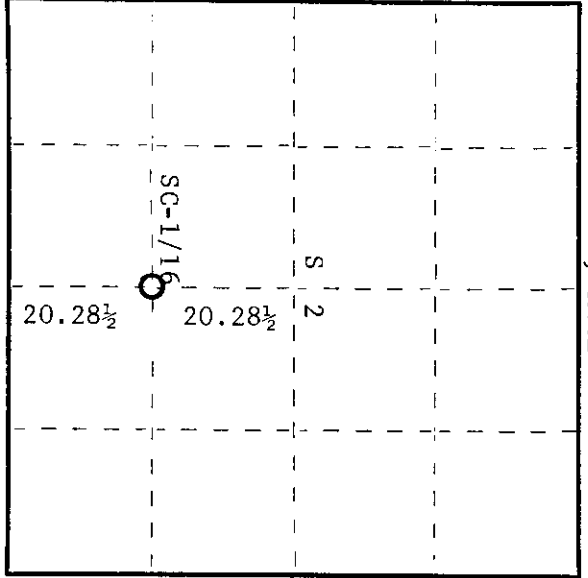

○ = Corner monument restored.

History of original corner establishment:

This corner established by H.C. Lawrence, Registered Land Surveyor, during his re-tracement survey in 1950.

Corner was set equidistant from his recovered C-1/4 Corner and the South 1/4 Corner at 20.28½ chains.

4" Cedar post was set, scribed SC-1/4 S2. No trees suitable for bearing trees.

Description of corner evidence found:

Recovered a 4" squared cedar post, scribed S2 SC-1/16; S2-SC-1/16 in poor condition. It was wired to a 1" x 5' iron pipe which had been placed beside the post.

No trace of bearing trees were recovered.

Description of monument and accessories I established to perpetuate the original location of this corner.

Set a 1" x 5' galvanized iron pipe with 2" brass cap stamped -

- New BT's. Red maple 5" S46°E 35 lks. Scribed 1/16 BT T36N, R11E
- Red maple 5" S88E 33-1/2 lks. Scribed 1/16 BT SC-1/16

S2

CPI-1974

Dated at Rhinelander, Wis., this 16th day of June, 1975

Signature: *Philip T. Hansen* Title: Registered Land Surveyor Registration No. S-498
(County Surveyor, Registered Land Surveyor, or other duly authorized official)

Office of Register of Deeds, County of Oneida. On the 1st day of October, 1975, I hereby certify that the within instrument was filed in this office for record on the 300 o'clock P.M.

Doris Terence Fuchsler
(Register of Deeds)

By _____ Deputy

3611021020