


CERTIFIED LAND CORNER RESTORATION

Index No. C-19

State of Wisconsin }
County of Oneida } ss.

I, Philip T. Hansen, do hereby certify that on the 16th day of January, 1975, I found evidence of the C-1/4 corner of Section 2 Township 36 N, Range 11 East, Fourth Principal Meridian, as described hereon; and that from this evidence I established a new monument and accessories as described hereon to perpetuate the original location of this corner.

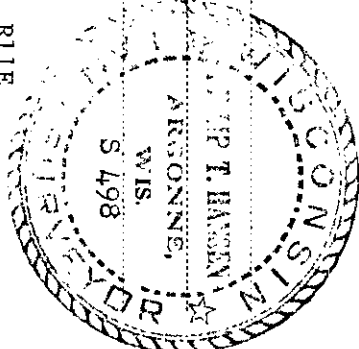

Resident witnesses:

History of original corner establishment:
Corner established by H.C. Lawrence, Registered Land Surveyor, in 1950.
Set 6" cedar post, squared and scribed C-1/4 S S2.


Description of corner evidence found:
Recovered 6" cedar post, squared and scribed C-1/4 S S2, fair condition, lying on the ground beside a 1" pipe, which had been driven in the post hole.

No BT's could be found.

Description of monument and accessories I established to perpetuate the original location of this corner.

- Set 2-1/2" x 5' galvanized iron pipe with brass cap stamped - S498
- New BT's. Tamarack 6" S84°W 92 lks. Scribed C-1/4 BT T36N, R11E
- Tamarack 4" S17°W 81 lks. Scribed C-1/4 BT

S | 2
C-1/4 |
CPI-1975

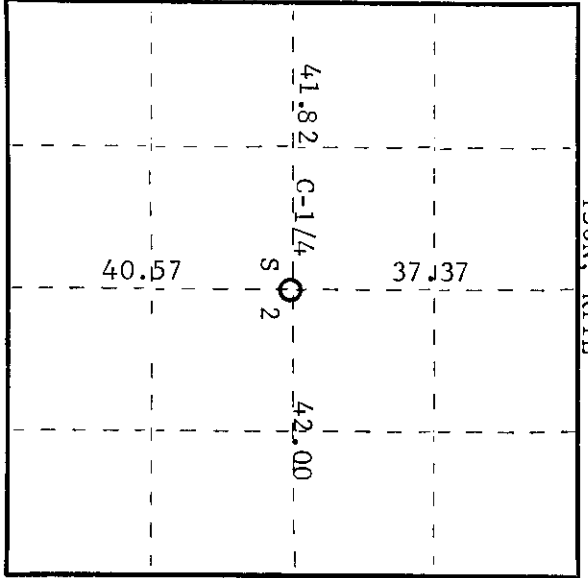

○ = Corner monument restored.

Dated at Rhinelander, Wis., this 16th day of June, 1975.
Signature: *Philip T. Hansen* Title: Registered Land Surveyor Registration No. S-498
(County Surveyor, Registered Land Surveyor, or other duly authorized official)

Office of Register of Deeds, County of Oneida, at 300 o'clock M. I hereby certify that the within instrument was filed in this office for record on the 1st day of October, 1975.

Doris Verne Fiedler
(Register of Deeds)

By: _____ Deputy

0702201198