

CERTIFIED LAND CORNER RESTORATION

Index No. **C-18**

State of Wisconsin

ss.

County of Oneida

I Philip T. Hansen

do hereby certify that on the 16th day

of January 19 75, I found

evidence of the WC-1/16

corner of Section 2

Township 36

11 East, North Range


as described hereon; and that from this evidence

I established a new monument and accessories


as described hereon to perpetuate the original

location of this corner.

Resident witnesses:

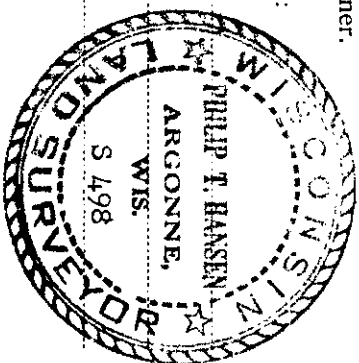

T36N, R11E

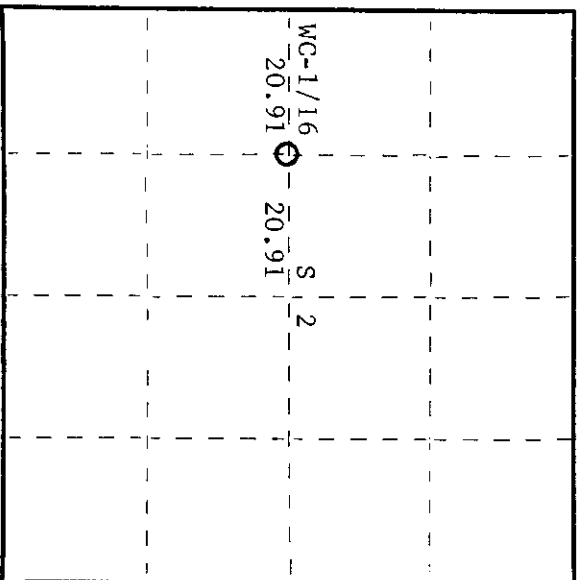

○ = Corner monument restored.

CERTIFIED LAND CORNER RESTORATION

History of original corner establishment:

H.C. Lawrence, Registered Land Surveyor, established this corner in 1950. He set a 4" hemlock post, squared and scribed, equidistant between his G-1/4 Corner and the W-1/4 Corner. Blazed and scribed NBT's. Sugar maple 10" S620E 58 lks.; Y. Birch 14" S20W, 50 lks.

Description of corner evidence found:

Recovered Lawrence's 4" hemlock post, squared and scribed WC-1/16 S2 in fair condition.

Recovered 10" sugar maple and 14" yellow birch stump but could not find evidence of scribing.

Description of monument and accessories I established to perpetuate the original location of this corner.

Set 1-1/4" O.D. Iron pipe with 2" brass cap stamped - S498

New BT. Red maple 8" N330W 26-2/3 lks. Scribed 1/16 BT T36N, R11E

WC-1/16 S 1/2

CPI-1974

Dated at Rhinelander Wis., this 16th day of June 19 75.

Signature: *Philip T. Hansen* Title: Registered Land Surveyor Registration No. S-498
(County Surveyor, Registered Land Surveyor, or other duly authorized official)

Office of Register of Deeds, County of Oneida. I hereby certify that the within instrument was filed in this office for record on the 1st day of October 19 75 at 3:00 o'clock P.M.

Doris Berge Tuelke
(Register of Deeds)

By: Deputy

3611022030