


CERTIFIED LAND CORNER RESTORATION


Index No. E-16

State of Wisconsin }
 County of Oneida } ss.

I, Phillip T. Hansen, do hereby certify that on the 10th day of January, 1975, I found evidence of the E-1/16 corner of Sections 3 and 10 Township 36 North, Range 11 East, Fourth Principal Meridian, as described hereon; and that from this evidence I established a new monument and accessories as described hereon to perpetuate the original location of this corner.

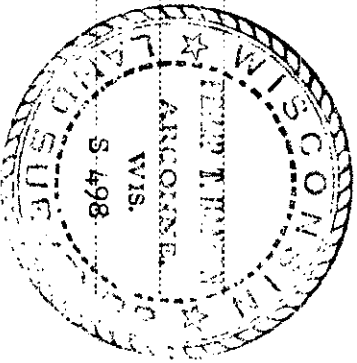

Resident witnesses:

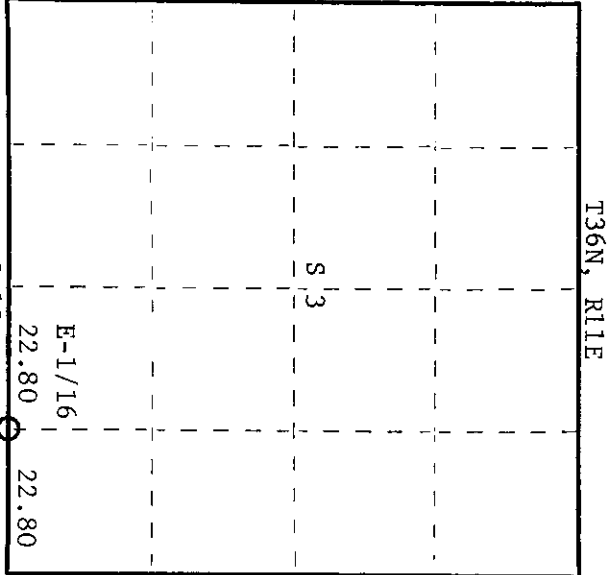

○ = Corner monument restored.

History of original corner establishment:

No record of this corner having been set prior to H.C. Lawrence's retracement survey of these sections in 1953.

He states that he ran a random line from the North 1/4 Corner between Sections 3 and 10 - due East to a point 128.19 chains, which was 6.74 chains North of the corner recovered by B.F. Dorr, which he claimed to have been the original corner. H.C. Lawrence set a 4" cedar post at 22.80 East of 1/4 Corner, Sections 3 and 10, and 28 lks. South of his random line marked new BT's. 7" cedar, S60E, 35 lks.; maple 6", (cluster of three), N50E, 24 lks.

Description of corner evidence found:

Recovered H.C. Lawrence's cedar post, squared and scribed, S3 E-1/16; S10 E-1/16 in fair condition.

Recovered BT's. Red maple 10" N48°E 23 lks. Scribed S3
 Cedar 7" S63°E 34-2/3 lks. Scribed S10

Description of monument and accessories I established to perpetuate the original location of this corner.

Replaced wooden cedar stake with 1" I.D. x 5' galvanized iron pipe with 2" brass cap stamped as follows -

Marked new BT. Red maple 6" N32°W 45-1/2 lks. Scribed 1/16 BT

S498
 T36N, R11E
 S 3
 E-1/16 - - -
 S 10
 CPI-1975

Dated at Rhinelander, Wis., this 10th day of June, 1975.

Signature: *Phillip T. Hansen* Title: Registered Land Surveyor Registration No. S-498
 (County Surveyor, Registered Land Surveyor, or other duly authorized official)

Office of Register of Deeds, County of Oneida. I hereby certify that the within instrument was filed in this office for record on the 1st day of October, 1975 at 3:00 o'clock P.M.

Dorci Terence Fuehn
 (Register of Deeds)

By: Deputy

01000301199