

CERTIFIED LAND CORNER RESTORATION



Index No. E-15

State of Wisconsin

County of Oneida } ss.

I, Phillip T. Hansen, do hereby certify that on the December 3 day of 1974, I found evidence of the quarter corner (1/4) corner of 3 and 10 Township 36, North, Range 11 East, Fourth, Principal Meridian, as described hereon; and that from this evidence I established a new monument and accessories as described hereon to perpetuate the original location of this corner.

Resident witnesses:

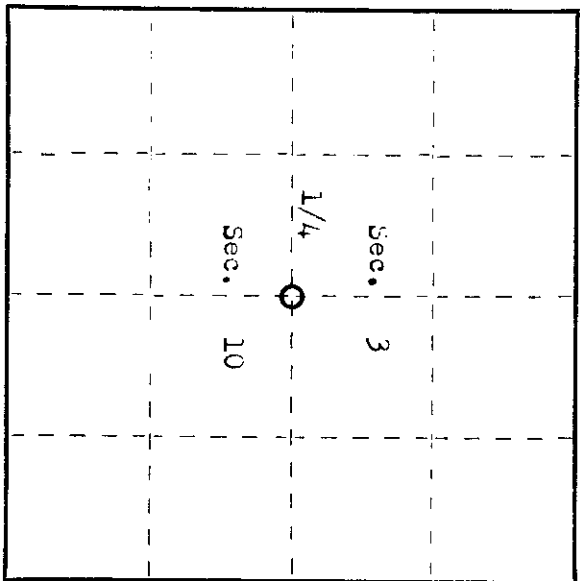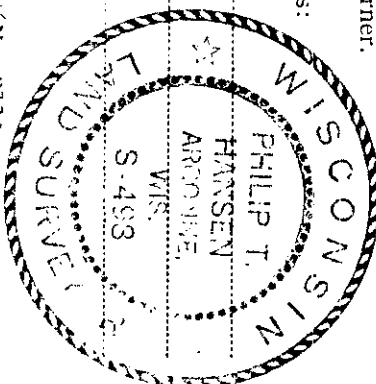

○ = Corner monument restored.

History of original corner establishment:

Original corner established by William E Dougherty Gov. Deputy Surveyor 1859

Ash	10"	S64E	26 lks
Ash	16"	N56W	14 lks

Description of corner evidence found: Recovered a 5" x 6" hemlock post, squared and scribed 1/4 C S 3- S10 laying on the ground, which was set by H.C. Lawrence in 1952. Recovered a 1" iron pipe set in the center of an old stove top, filled with stone, which Lawrence had placed around his hemlock post.

H.C. Lawrence notes stated that he had recovered the Elm stump of RR established by Vaughan in 1907 with scribe marks visible. From Vaughan notes in the Court House he stated he had found the original Government B.T.s.

Recovered B.T.s established by H.C. Lawrence 1952			
Stump	13"	S85E	48 lks.
Elm	17"	S23W	55 1/2 lks

Description of monument and accessories I established to perpetuate the original location of this corner.

Set 2 1/2" x 5" Galvanized iron pipe with brass cap stamped as follows:

Blazed and scribed Black Ash 7" S47W 26 lks

S-498
T36N R11E
1/4 S3
S10

OFF 1 1974


Signature: Phillip T. Hansen Title: Registered Land Surveyor Registration No. S 498
(County Surveyor, Registered Land Surveyor, or other duly authorized official)

Office of Register of Deeds, County of Oneida.
Instrument was filed in this office for record on the 1st day of December, 19 75 at 3:00 o'clock P. M.

Terrie Verage Furlan
(Register of Deeds)

By: _____ Deputy

36 11030020