

CERTIFIED LAND CORNER RESTORATION


Index No. D-16

State of Wisconsin


County of Oneida } ss.

I, Philip T. Hansen, do hereby certify that on the 23rd day of January, 1975, I found evidence of the SE-1/16 corner of Section 3 Township 36, North, Range 11 E, Fourth Principal Meridian, as described hereon; and that from this evidence I established a new monument and accessories as described hereon to perpetuate the original location of this corner.

Resident witnesses:

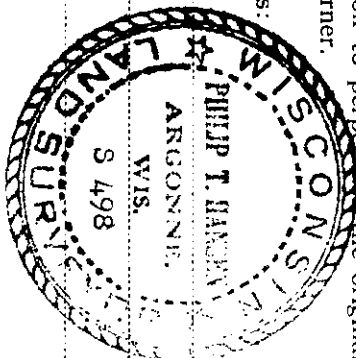

T36N R11E

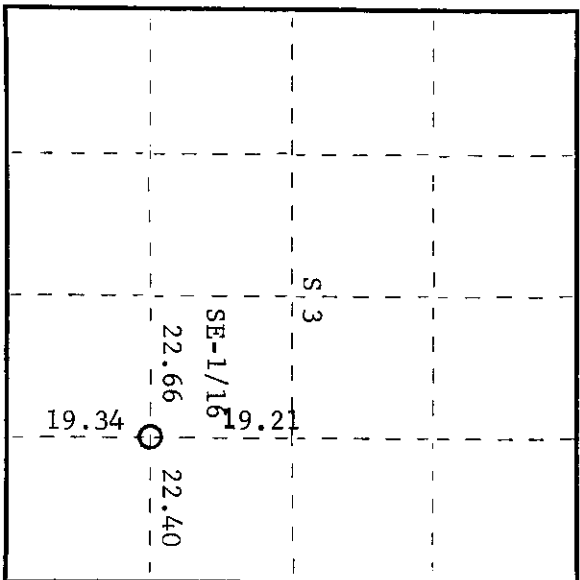

○ = Corner monument restored.

History of original corner establishment:

Corner established by H.C. Lawrence, Registered Land Surveyor, during his retracement and subdivision of Section 3. From EC-1/16 corner ran S1°00'E on random line, at 19.46 intersect 1/4 line of SE-1/4 at 22.84 chains east. Intersected true line of Sec. 3 and 10 at 37 links east of E-1/16 corner. SE-1/16 corner set at 22.66 chains east of SC-1/16 corner and 19.43 chains north of E-1/16 corner.

Set 4" cedar post.
BT's - White birch 8" N50W 36½ links
White birch 6" S75°W 41½ links

Description of corner evidence found:

Recovered 4" cedar post, squared and scribed S3 SE-1/16 in fair condition.
Recovered BT's - White birch 8" N50W 36½ links green scribing grown over
White birch 6" S75W 41½ links green scribing grown over

Description of monument and accessories I established to perpetuate the original location of this corner.
Replaced wooden stake with 1-1/4"OD x 5' galvanized iron pipe w/brass cap stamped -

S498
T36N R11E

SE-1/16 ~~3~~
CPT-1975

Dated at Rhineland, Wis., this 16th day of June, 1975.

Signature Philip T. Hansen Title Registered Land Surveyor Registration No. S-498
(County Surveyor, Registered Land Surveyor, or other duly authorized official)

Office of Register of Deeds, County of Oneida I hereby certify that the within instrument was filed in this office for record on the 1st day of October, 1975 at 3:00 o'clock P. M.

Doris Vernege Suelha
(Register of Deeds)

By: _____ Deputy

3611031010