

CERTIFIED LAND CORNER RESTORATION

Index No. **D-15**

State of Wisconsin

County of Oneida } ss.

I, Philip T. Hansen, do hereby

certify that on the 20th day of January, 1975, I found


evidence of the SC-1/16 corner of Section 3

Township 36, North, Range 11 E, Fourth Principal Meridian,


as described hereon; and that from this evidence I established a new monument and accessories

as described hereon to perpetuate the original location of this corner.

Resident witnesses:

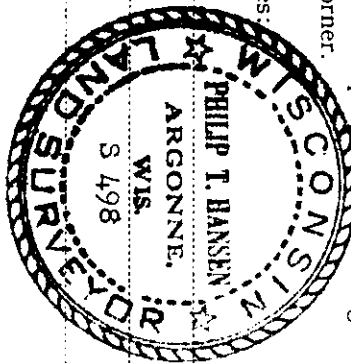

T36N R11E

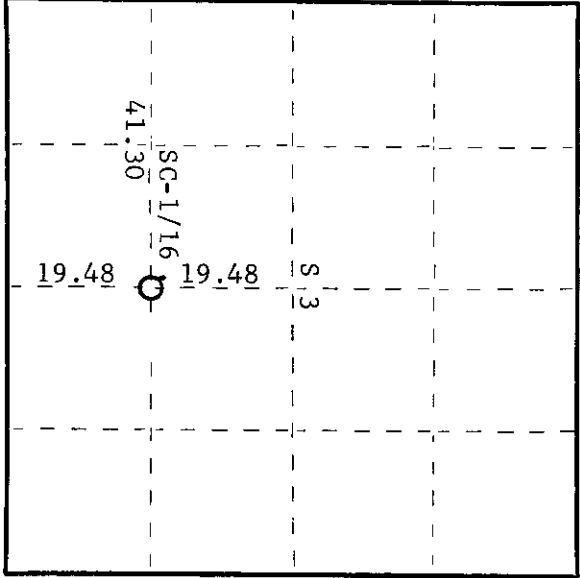

○ = Corner monument restored.

History of original corner establishment:

Corner established by H.C. Lawrence, Registered Land Surveyor, during his retracement survey of 1952.

Set 4" squared and scribed cedar post, SC-1/16 S3, 52.04 chains south of N-1/4 corner.

BT's - Maple 7" N60E 23 links
Maple 10" N70W 25 links

Description of corner evidence found:

Recovered 4" cedar post, squared and scribed SC-1/16 S3 in fair condition.

Recovered old BT's - Maple 7" N60°E 23 links green and scribing grown over
Maple 10" N70W 25 links green and scribing grown over

Description of monument and accessories I established to perpetuate the original location of this corner.

Replaced wooden post with 1-1/4"OD x 5' galvanized iron pipe w/brass cap stamped -

No new BT's established.

SC-1/16 S3
CPI-1975

Dated at Rhineland, Wis., this 16th day of June, 1975

Signature *Philip T. Hansen* Title Registered Land Surveyor Registration No. S-498
(County Surveyor, Registered Land Surveyor, or other duly authorized official)

Office of Register of Deeds, County of Oneida. I hereby certify that the within instrument was filed in this office for record on the 1st day of October, 1975 at 3:00 o'clock P.M.

Tonia Terence Tuckler
(Register of Deeds)

By: Deputy

3611031020