CERTIFIED LAND CORNER RESTORATION

Index No. C-17

State of Wisconsin
County of Oneida } ss.

I Philip T. Hansen, do hereby certify that on the 2nd day of January, 19 75, I found evidence of the Quarter corner of 2 and 3 Township 36, North, Range 11 East, Fourth Principal Meridian, as described hereon; and that from this evidence I established a new monument and accessories as described hereon to perpetuate the original location of this corner.

Resident witnesses:

WISCONSIN PHILIP T. HANSEN ARGONNE, WIS. S 498 LAND SURVEYOR

T36N, R11E

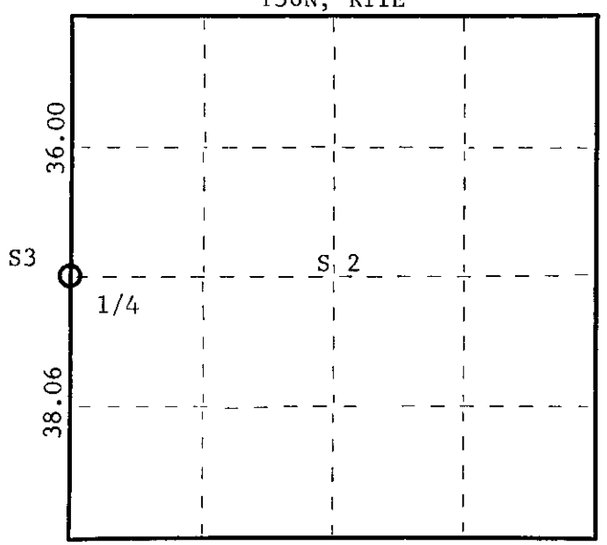

○ = Corner monument restored.

History of original corner establishment:
Original corner established by Wm. E. Dougherty, Gov't Deputy Surveyor in 1859.
Resurvey by D.H. Vaughan in 1908. Recovered and reset the 1/4 corner.
Retracement survey by H.C. Lawrence, Reg. Land Surveyor, 1950.
Recovered corner set by D.H. Vaughan. Set new post and made two new BT's.

Spruce 14"	S80E	40 lks.
B. Ash 10"	N55W	30 lks.

Description of corner evidence found:
Recovered 4" cedar post, squared and scribed S2-1/4; S3-1/4 in good condition.
Someone had placed a 1" iron pipe beside the wood post.

Recovered old BT	Black ash 10"	N55W	30 lks.
	No other BT's visible.		

Description of monument and accessories I established to perpetuate the original location of this corner.
Set new 2-1/2" x 5' galvanized iron pipe with brass cap stamped -

S498
T36N, R11E
S3-S2
1/4

New BT's	Black ash 8"	N71°E	26½ lks.	scribed 1/4 BT
	Black ash 6"	N1°W	43-3/4 lks.	scribed 1/4 BT

CPI-1975

Dated at Rhinelander, Wis., this 16th day of June, 19 75.

Signature Philip T. Hansen Title Registered Land Surveyor Registration No. S-498
(County Surveyor, Registered Land Surveyor, or other duly authorized official)

Office of Register of Deeds, County of Oneida, I hereby certify that the within instrument was filed in this office for record on the 1st day of October, 19 75 at 3:00 o'clock P. M.

Dorie Verage Kuehn
(Register of Deeds)

By ..... Deputy

FORM 985 H C MILLER CO., MILWAUKEE

361032000