

CERTIFIED LAND CORNER RESTORATION

Index No. **B-17**

State of Wisconsin }
 County of Oneida } ss.


History of original corner establishment:
 Corner established by H.C. Lawrence, Registered Land Surveyor. Set 5" cedar post, squared and scribed S2 N-1/16, S3 N-1/16.

Established BT's - Elm 9" N60E 27 links
 Elm 9" S45W 21 links

I, Philip T. Hansen, do hereby certify that on the 20th day of January, 19 75, I found evidence of the N-1/16 corner of Sections 2 & 3 Township 36 North, Range 11 East, Fourth Principal Meridian, as described hereon; and that from this evidence I established a new monument and accessories as described hereon to perpetuate the original location of this corner.


Description of corner evidence found:
 Recovered 5" cedar post, squared and scribed S2 N-1/16, S3 N-1/16 in poor condition.
 Recovered BT's - Elm 9" N60E 27 links scribing grown over
 Elm 9" S45W 21 links scribing grown over

Resident witnesses:

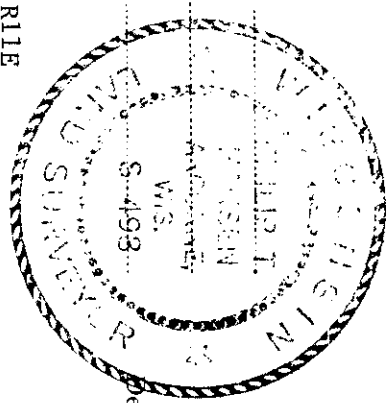

Description of monument and accessories I established to perpetuate the original location of this corner.
 Set new 1-1/4" O.D. x 5' galvanized iron pipe with 2" brass cap stamped -
 No new BT's established.

S498
 T36N, R11E
 S3+S2
 N-1/16
 CPI-1975

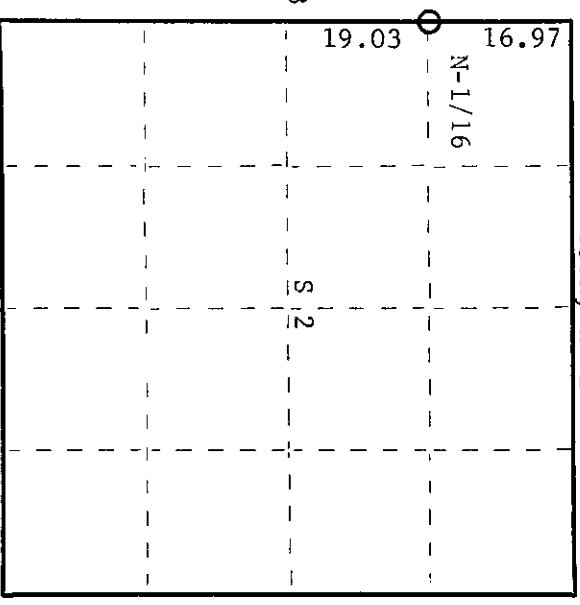

S3

O = Corner monument restored.

Dated at Rhinelander, Wis., this 16th day of June, 19 75

Signature *Philip T. Hansen* Title Registered Land Surveyor Registration No. S-498
 (County Surveyor, Registered Land Surveyor, or other duly authorized official)

Office of Register of Deeds, County of Oneida. I hereby certify that the within instrument was filed in this office for record on the 1st day of October, 19 75 at 3:00 o'clock P.M.

Donie Terage Kuehn
 (Register of Deeds)

By Deputy

000M20119M