

CERTIFIED LAND CORNER RESTORATION

Index No. **B-16**

State of Wisconsin

County of Oneida } ss.

Philip T. Hansen

do hereby certify that on the 20th day of January 1975, I found

evidence of the NE-1/16



corner of Section 3

Township 36 North, Range 11 E

, Fourth Principal Meridian,

as described hereon; and that from this evidence I established a new monument and accessories as described hereon to perpetuate the original location of this corner.

Resident witnesses:

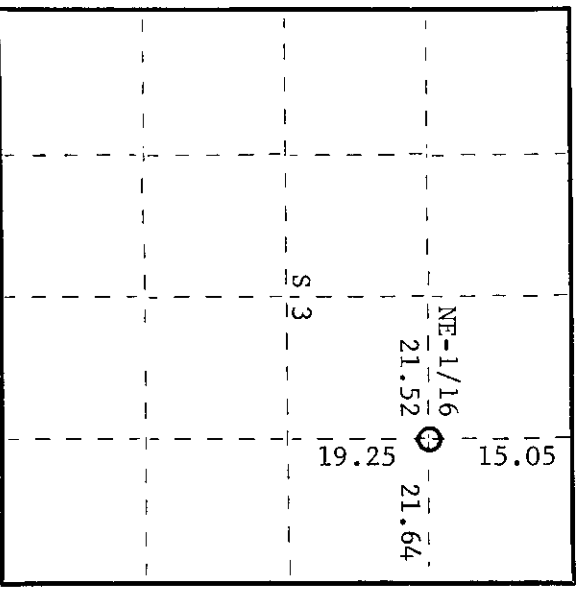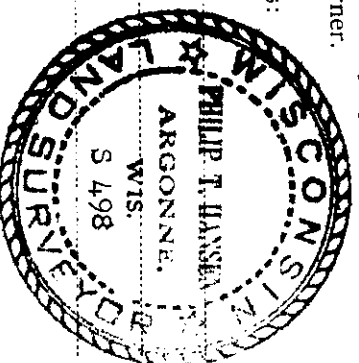

○ = Corner monument restored.

History of original corner establishment:

Corner established by H.C. Lawrence, Registered Land Surveyor, during his retracement survey of 1952.

Set 5" cedar post, squared and scribed at 15.05-1/2 chains south of E-1/16 post on Town Line 21.52 chains east of NC-1/16 corner.

BT's - Sugar maple 5" N68°E 12 links
Sugar maple 7" S70°W 16 links

Description of corner evidence found:

Recovered 5" cedar post, squared and scribed NE-1/16 S3; NE-1/16 S3 in poor condition. Post was wired to an iron pipe.

Recovered old BT's - Sugar maple 5" N68°E 12 links scribing grown over
Sugar maple 7" S70°W 16 links scribing grown over

Description of monument and accessories I established to perpetuate the original location of this corner.

Replaced wooden post with 1-1/4"OD x 5' galvanized iron pipe stamped -

NBT - Sugar maple 7" S80W 28 links scribed 1/16 BT.

S498
T36N R11E
NE-1/16
S3
CPI-1975

Dated at Rhinelander, Wis., this 16th day of June, 1975.

Signature *Philip T. Hansen* Title Registered Land Surveyor Registration No. S-498
(County Surveyor, Registered Land Surveyor, or other duly authorized official)

Office of Register of Deeds, County of Oneida. I hereby certify that the within instrument was filed in this office for record on the 1st day of October, 1975 at 3:08 o'clock P.M.

Sonia George Tuelke
(Register of Deeds)

By Deputy

010203011178