CERTIFIED LAND CORNER RESTORATION

Index No. E-11

State of Wisconsin
County of Oneida } ss.

I Philip T. Hansen, do hereby certify that on the 1st day of May, 1975, I found evidence of the Quarter corner of Sections 4 and 9 Township 36, North, Range 11 East, Fourth Principal Meridian, as described hereon; and that from this evidence I established a new monument and accessories as described hereon to perpetuate the original location of this corner.

Resident witnesses:

Glen Barker

Jim Claflin

WISCONSIN PHILIP T. HANSEN ARBORNE, WIS. S-498 LAND SURVEYOR

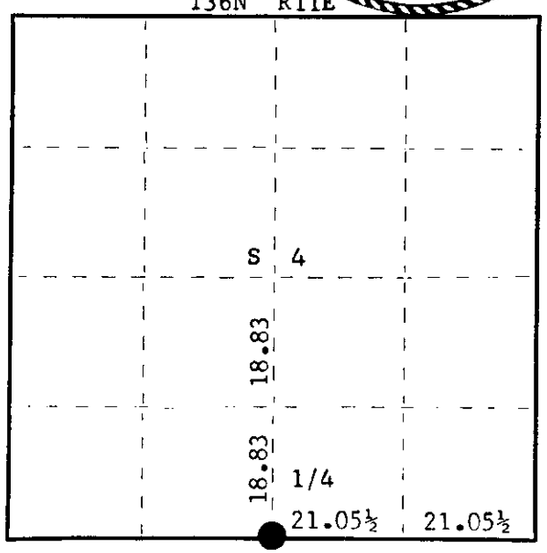

○ = Corner monument restored.

History of original corner establishment:

Original corner established by Wm. E. Dougherty, deputy surveyor, in 1859 from which white birch 10" bears N85°W 8 links and white birch 10" bears S80°E 10 links.
D.H. Vaughan, county surveyor, recovered original corner in 1907.
H.C. Lawrence, Registered Land Surveyor, re-established the corner in 1952. The corner had been destroyed by road construction, highway 45. He used ties to Vaughan's SE 1/16 section 4 and the Vaughan's N-S 1/4 line section 9. Set a new post, but no BT's were available.
Wes White, CPI forester, set a 1-1/2" iron pipe for witness corner 110 links west, prior to relocation of highway 45, which would have destroyed the true corner.

Description of corner evidence found:

Recovered 1-1/2" iron pipe with 5" squared cedar post laying beside it 110 links west of true corner. Post scribed S9 1/4S S4 1/4.
No OBT's recovered.

Description of monument and accessories I established to perpetuate the original location of this corner.

Replaced iron pipe with 2-1/2" iron pipe with brass cap, stamped:
Marked NBT's to true corner -
White Birch 6" N76°W 120.1 links
White Birch 6" S75°W 135.5 links, scribed 1/4 BT.

T36N R11E
1/4 S 4 / S 9 W.C.
E - 110 lks.

Dated at Rhinelander, Wis., this 2nd day of January, 1980

Signature Philip T. Hansen Title Registered Land Surveyor Registration No. S-498
(County Surveyor, Registered Land Surveyor, or other duly authorized official)

Office of Register of Deeds, County of Oneida, I hereby certify that the within instrument was filed in this office for record on the 11th day of February, 1980 at 2:15 o'clock P M.

Doris Verage Kuehn
(Register of Deeds)

By ..... Deputy

36110400 20

FORM 985 H C MILLER CO. MILWAUKEE