

CERTIFIED LAND CORNER RESTORATION



Index No. **D-11**

State of Wisconsin

County of Oneida } ss.

I, Phillip T. Hansen, do hereby certify that on the 17th day of June, 1975, I found evidence of the SC-1/16 corner of Section 4 Township 36, North, Range 11 East, Fourth Principal Meridian, as described hereon; and that from this evidence I established a new monument and accessories as described hereon to perpetuate the original location of this corner.

Resident witnesses:

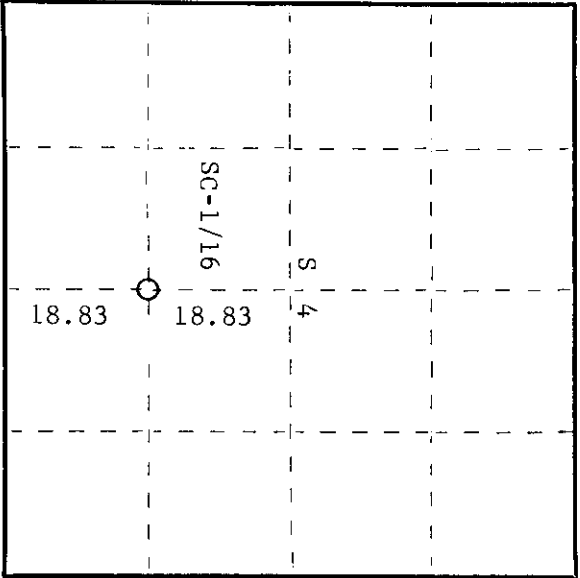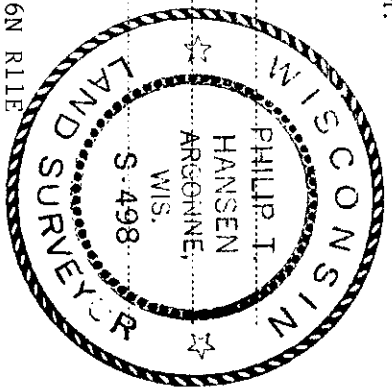

○ = Corner monument restored.

3611041620

History of original corner establishment:


Corner established by D.H. Vaughan, County Surveyor, in 1907, from which cedar 6" bears N87°W 2 1/2 links, and birch 10" bears N21 1/2°E 13-3/4 links. Corner recovered by H.C. Lawrence, Registered Land Surveyor, in 1946, during his retracement survey. He recovered Vaughan's post standing and his BT's were intact and standing. He set a new 5" cedar post.

Description of corner evidence found:

Recovered Lawrence's 5" cedar post, squared and scribed SC-1/16 S4, SC-1/16 S4, in poor condition. Recovered the point of Vaughan's old post in the muck while cleaning out the hole for new pipe.
Recovered OBT's - birch 10" N21 1/2°E 13-3/4 links (now a decayed stump).
Cedar 6" N87°W 2-1/4 links (now a 3' stub). Scribing had been cut out.

Description of monument and accessories I established to perpetuate the original location of this corner.

Replaced 5" cedar post with 2 1/2" iron pipe with brass cap stamped - S498
NBT's - black ash 6" S44°E 8 links scribed 1/16 BT.
Black ash 9" N52°W 10 1/2 links scribed 1/16 BT.

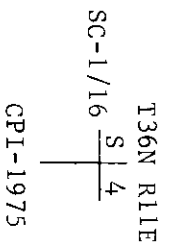

Dated at Rhineland, Wis., this 10th day of July, 1975.

Signature: Phillip T. Hansen Title: Registered Land Surveyor Registration No. S-498
(County Surveyor, Registered Land Surveyor, or other duly authorized official)

Office of Register of Deeds, County of Oneida
Instrument was filed in this office for record on the 1st day of October 1975
at 3:00 o'clock P.M.

Tonia Virginia Fuchs
(Register of Deeds)

By: _____ Deputy