


CERTIFIED LAND CORNER RESTORATION

Index No. C-11


State of Wisconsin

County of Oneida } ss.

I, Phillip T. Hansen, do hereby certify that on the 27th day of March, 1975, I found evidence of the center 1/4 corner of Section 4, Township 36 North, Range 11 East, Fourth Principal Meridian, as described hereon; and that from this evidence I established a new monument and accessories as described hereon to perpetuate the original location of this corner.

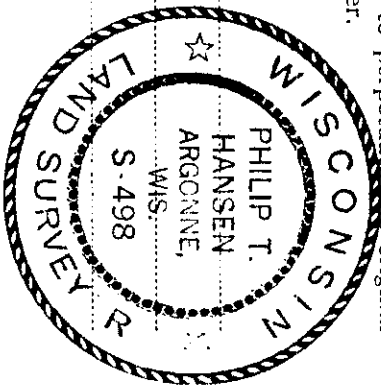

Resident witnesses:

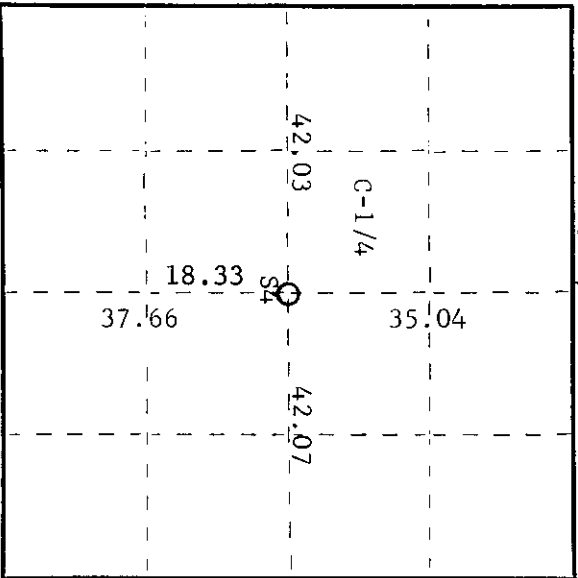

○ = Corner monument restored.

CERTIFIED LAND CORNER RESTORATION

Index No. C-11

History of original corner establishment:

Original corner established by D.H. Vaughan, Oneida County Surveyor, in 1907. Corner re-established by H.C. Lawrence, Registered Land Surveyor, in 1952. He had recovered Vaughan's SC-1/16 corner intact in 1946 and had remarked it with a new post. From the SC-1/16 corner he ran a random line S1°30'E, 18.33 chains to a point 38 links East of the 1/4 corner. He then started from the SC-1/16 corner and ran N1°30'W, a distance of 18.33 chains, using the SC-1/16 corner as an axis, then offset 38 links East. Extensive search recovered an old stake, well pointed, but not scribed lying under moss. He set new post for C-1/4 corner, from which tamarack 9" bears N60W, 51 links and tamarack 7" bears S40W, 51-1/2 links.

Description of corner evidence found:

Recovered 5" cedar post, squared and scribed C-1/4S S4; C-1/4S S4 in fair condition. Also found a 1-1/2" O.D. iron pipe set beside the wooden post. Recovered BT's - Tamarack 11" N54°W 47.3 links scribed S4 Tamarack 9" S31°W 48.8 links scribing grown over. The bearings and distances do not check with original calls for these BT's, but there was no evidence of the corner having been moved.

Description of monument and accessories I established to perpetuate the original location of this corner.

Replaced wood post with 2-1/2" x 5' galvanized iron pipe with brass cap stamped -

No new BT's established.

C-1/4 S4

CPI-1975

T36N, R11E

S498

Dated at Rhinelander, Wis. this 15th day of May, 1975.

Signature: *Phillip T. Hansen* Title: Registered Land Surveyor Registration No. S-498
(County Surveyor, Registered Land Surveyor, or other duly authorized official)

Office of Register of Deeds, County of Oneida, at 300 o'clock P.M. 1st day of October, 1975. I hereby certify that the within instrument was filed in this office for record on the 1st day of October, 1975.

Doris Verage Kuehn
(Register of Deeds)

By: Deputy