

CERTIFIED LAND CORNER RESTORATION

Index No. **E-8**


State of Wisconsin

County of Oneida } ss.

History of original corner establishment:  
Original corner established by H.C. Lawrence, Registered Land Surveyor, during his retracement survey. Set 5" cedar post, equidistant between corner sections 4-5-8-9 and 1/4 corner Sec. 5 and Sec. 8 at 20.70 chains, from which aspen 14" bears S50°E, 19 links.

I, Phillip T. Hansen, do hereby certify that on the 24th day of March, 1975, I found evidence of the E-1/16 corner of Sections 5 and 8 Township 36 North, Range 11 East, Fourth Principal Meridian, as described hereon; and that from this evidence I established a new monument and accessories as described hereon to perpetuate the original location of this corner.

Resident witnesses

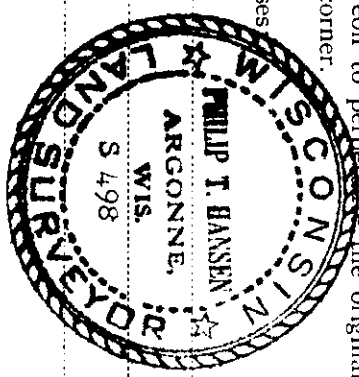


Description of monument and accessories I established to perpetuate the original location of this corner.  
Set 1-1/4" O.D. x 5' galvanized iron pipe with 2" brass cap in old posthole stamped -

NBT's - Red maple 5" N18°W 32.8 links scribed 1/16 BT T36N, R11E S498  
Red maple 5" N52°W 52.6 links scribed 1/16 BT

E-1/16 S 5  
S 8

GPT-1975

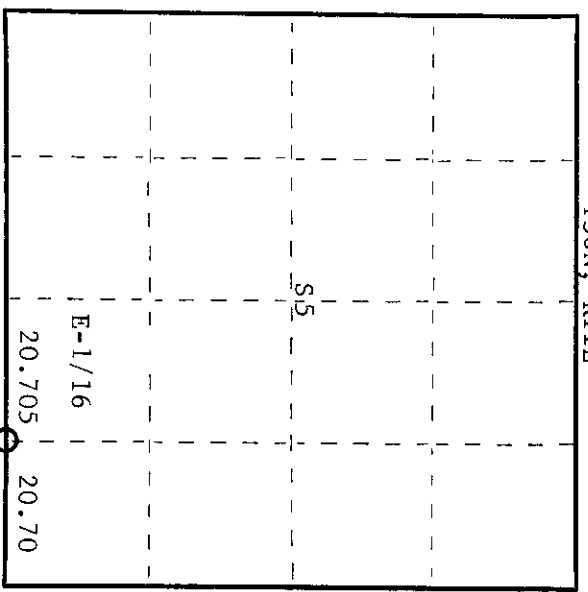

○ = Corner monument restored.

3611050010

Description of corner evidence found:  
Recovered H.C. Lawrence's 4" cedar post, squared and scribed EC-1/16 S5, EC-1/16 S8 in fair condition. Post had fallen down.  
Note error in scribing corner.  
Recovered an old, rotten aspen stump, scribed BT S1°W, 20.2 links.

Dated at Rhinelander, Wis., this 16th day of June, 1975.

Signature *Phillip T. Hansen* Title Registered Land Surveyor Registration No. S-498  
(County Surveyor, Registered Land Surveyor, or other duly authorized official)

Office of Register of Deeds, County of Oneida  
Instrument was filed in this office for record on the 1st day of October, 1975 at 3:00 o'clock P.M.

Signature *Doris Verage Tucker*  
(Register of Deeds)

By Deputy