CERTIFIED LAND CORNER RESTORATION

Index No. E-6

State of Wisconsin
County of Oneida } ss.

I Philip T. Hansen, do hereby certify that on the 19th day of March, 19 75, I found evidence of the W-1/16 corner of Sections 5 and 8 Township 36 North, Range 11 East, Fourth Principal Meridian, as described hereon; and that from this evidence I established a new monument and accessories as described hereon to perpetuate the original location of this corner.

Resident witnesses:

WISCONSIN LAND SURVEYOR
PHILIP T. HANSEN
ARGONNE, WIS.
S 498

T36N R11E

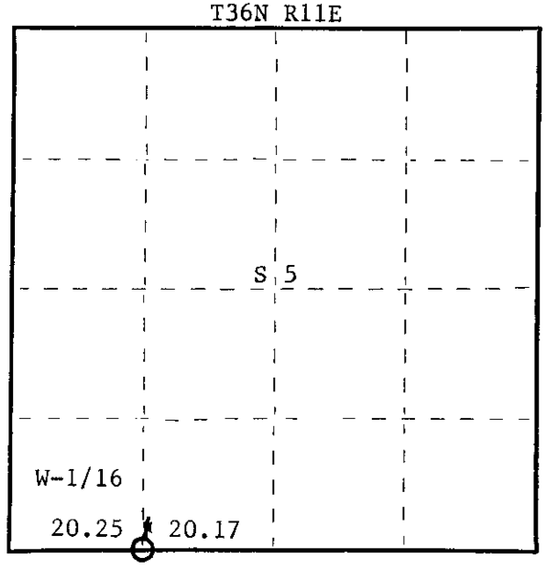

O = Corner monument restored.

History of original corner establishment:

Original corner established by D.H. Vaughan, County Surveyor, in 1904.

Hemlock	S59W	13	links
Tamarack	S40½E	16-3/4	links

Corner recovered by H.C. Lawrence, Reg. Land Surveyor, during his retracement survey of 1947. Found his old post lying under a windfall and recovered the hole in which it stood. Found remains of his hemlock S59°W, 13 links and tamarack S40½E, 16-3/4 links. Set a new 3½" cedar post in old post hole from which a white birch, 7", bears N75°E, 11½ links, white birch, 7", bears N89°W, 27 links, and balsam, 9", bears S26°W, 14 links.

Description of corner evidence found:

Recovered H. C. Lawrence's 3½" cedar post, squared, and scribed S5 W-1/16 S8, standing but in poor condition.

Recovered white birch	7" (now 11")	N82°W	27 links	scribed W-1/16 S8 NBT
white birch	7" (now 11")	N87°E	123 links	scribed W-1/16 NBT
No trace of balsam 9".				

Description of monument and accessories I established to perpetuate the original location of this corner.

Replaced wooden post with 1¼" OD x 50" galvanized iron pipe w/2" brass cap, stamped -

S498
T36N R11E

W-1/16 S 5 / S 8

CPI-1975

No NBT's established.

Dated at Rhinelander, Wis., this 10th day of June, 19 75

Signature Philip T. Hansen Title Registered Land Surveyor Registration No. S-498
(County Surveyor, Registered Land Surveyor, or other duly authorized official)

Office of Register of Deeds, County of Oneida, I hereby certify that the within instrument was filed in this office for record on the 1st day of October, 19 75 at 3:00 o'clock P. M.

Doris Verage Kuehn
(Register of Deeds)

By ..... Deputy

FORM 983 H C MILLER CO., MILWAUKEE

36110500030