

CERTIFIED LAND CORNER RESTORATION

Index No. E-5

State of Wisconsin


County of Oneida } ss.

I Phillip T. Hansen, do hereby certify that on the 6th day of May, 1975, I found evidence of the Section Corner corner of Sections 5, 6, 7 and 8 Township 36, North, Range 11 East, Fourth Principal Meridian, as described hereon; and that from this evidence I established a new monument and accessories as described hereon to perpetuate the original location of this corner.


Resident witnesses:

Glen Barker

Jim Clafflin

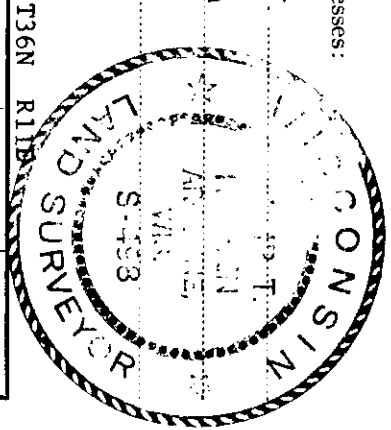

T36N R11E

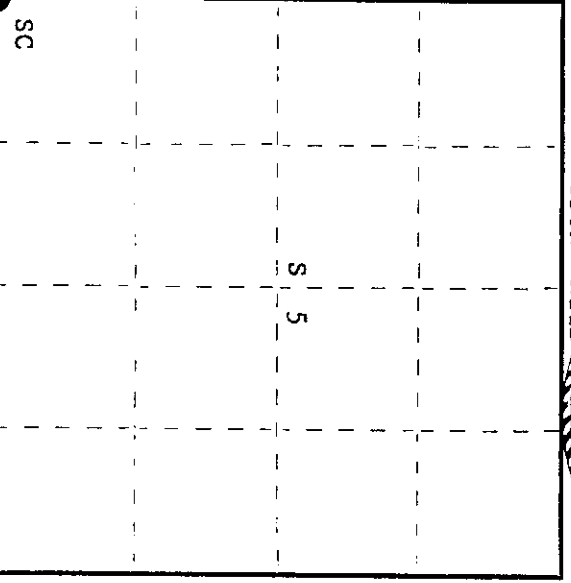

○ = Corner monument restored.

History of original corner establishment:

Original corner established by Wm. E. Dougherty, deputy surveyor, in 1859 from which tamarack 8" bears N 5° E 40 links; tamarack 8" bears N 16° W 31 links. Corner recovered by D.H. Vaughan, county surveyor. H.C. Lawrence, Registered Land Surveyor, ran the line between section 5 and 6 in 1950. Recovered an old post in long grass on east side of road, no evidence of any OBT's recovered. Set new post, but no trees available for BT's. N. Loftus, Ripco surveyor, accepted this corner in 1962. Set new post.

Description of corner evidence found:

Recovered Ripco's 2" iron pipe with brass cap, stamped: Pipe was in excellent condition. No BT's recovered.

T36N R11E  
S6 + S5  
S7 + S8  
RIPCO

Description of monument and accessories I established to perpetuate the original location of this corner.

Left Ripco's iron pipe in place as recovered. Set a 1-1/2" iron pipe for W.C. S57°E 74.2 links, stamped W.C. Marked NBT - B. Spruce 3" S83°W 100.2 links, scribed SC BT.

Dated at Rhinelander, Wis., this 2nd day of January, 1980

Signature: Phillip T. Hansen Title Registered Land Surveyor Registration No. S-498  
(County Surveyor, Registered Land Surveyor, or other duly authorized official)

Office of Register of Deeds, County of Oneida I hereby certify that the within instrument was filed in this office for record on the 11th day of February, 1980 at 2:15 o'clock P.M.

Donna George Fuchs  
(Register of Deeds)

By: \_\_\_\_\_ Deputy

3611060000