

CERTIFIED LAND CORNER RESTORATION

Index No. **E-3**

State of Wisconsin


County of Oneida } ss.

I Phillip T. Hansen, do hereby certify that on the 17th day of November, 1975, I found evidence of the Quarter corner of Sections 6 and 7 Township 36 North, Range 11 East, Fourth Principal Meridian, as described hereon; and that from this evidence I established a new monument and accessories as described hereon to perpetuate the original location of this corner.


Resident witnesses:

Glen Barker

Jim Claflin

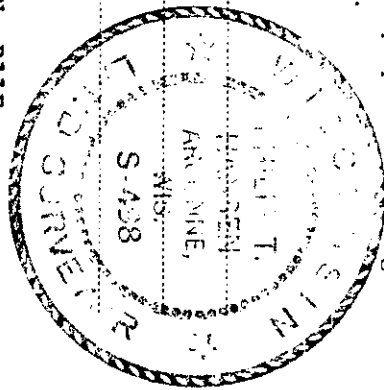

T36N, R11E

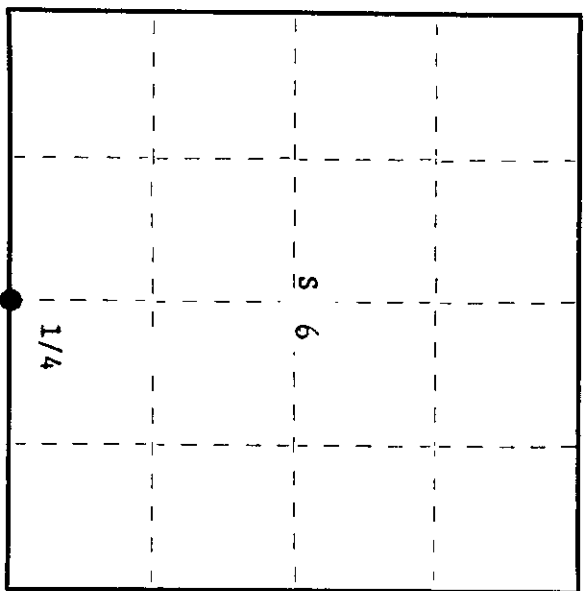

○ = Corner monument restored.

History of original corner establishment:

Original corner established by Wm. E. Dougherty, Deputy Surveyor, in 1859, from which tamarack 8" bears N47°W, 14 lks. and tamarack 10" bears S31°E, 11 lks. This corner reset by B.F. Dorr in 1888. His notes say that he thinks the original surveyors never did run this line. Dorr set the Quarter Corner and the W-1/16 corner from his random line between the Section Corners, which he recovered. D.H. Vaughan, County Surveyor, set the E-1/16 corner in 1905 using Dorr's Quarter Corner and Section Corners 5, 6, 7, and 8. Corner re-established by H.C. Lawrence, using Vaughan's E-1/16 corner, which he recovered and the Section Corner on range line. Set 4" tamarack post and marked NBT's - cherry 8", N26°W, 30-1/2 lks. and aspen 9", N1°E, 14 lks. and aspen 8" S1°W, 11 lks.

Description of corner evidence found:

Recovered Lawrence's 4" tamarack post, squared and scribed 1/4 S S6, 1/4 S S7 in poor condition.

Recovered OBT's - Aspen 9"	N1°E	14 lks.	now a cut-off stump
Aspen 8"	S1°W	11 lks.	now a cut-off stump
B. cherry 8"	N26°W	30.5 lks.	now a 4' stub, scribed 1/4 S NBT

Description of monument and accessories I established to perpetuate the original location of this corner.

Replaced 4" tamarack post with 2-1/2" iron pipe with brass cap stamped -
 Pipe projects 18" above ground.
 This area has been completely cut off so no BT's were available.
 Established two reference pipes. 1" iron pipes with brass cap projecting two feet above ground. S498
 T36N, R11E

No. 1 - South	45 lks.	stamped W.C. N45 lks.	1/4 S 6
No. 2 - East	25 lks.	stamped W.C. W25 lks.	S 7

Pipe and reference corners painted blue. CPI-1975

Dated at Rhinelander, Wis., this 29th day of November, 1975

Signature Phillip T. Hansen Title Registered Land Surveyor Registration No. S-498
 (County Surveyor, Registered Land Surveyor, or other duly authorized official)

Office of Register of Deeds, County of Oneida
 Instrument was filed in this office for record on the 4th day of January, 1976
 at 1:00 o'clock P.M.

George A. ...
 (Register of Deeds)

By: _____ Deputy

02009002