

CERTIFIED LAND CORNER RESTORATION

Index No. E-2

State of Wisconsin



County of Oneida } ss.

I Phillip T. Hansen, do hereby certify that on the 17th day of November, 1975, I found evidence of the W-1/16 corner of Sections 6 and 7 Township 36 North, Range 11 East, Fourth Principal Meridian, as described hereon; and that from this evidence I established a new monument and accessories as described hereon to perpetuate the original location of this corner.

Resident witnesses:

Glen Barker

Jim Clafin

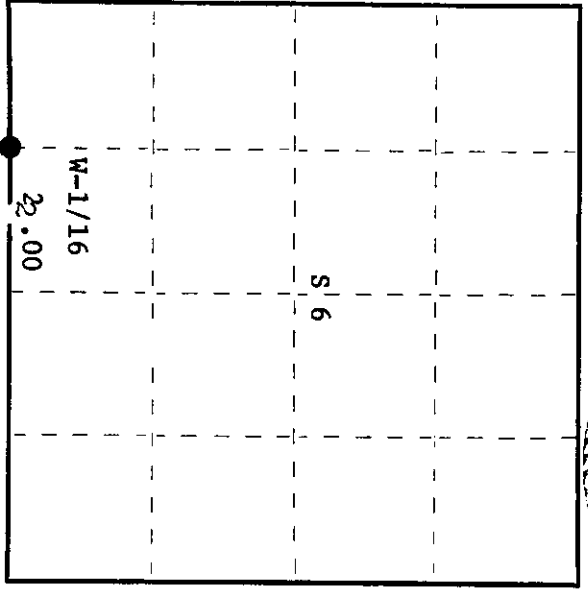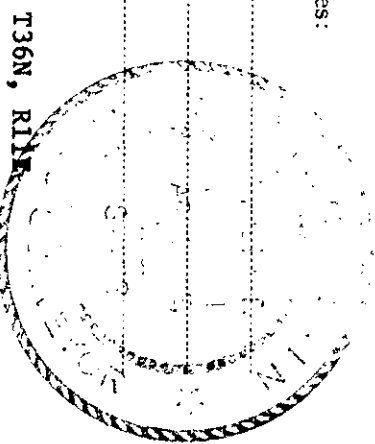

○ = Corner monument restored.

History of original corner establishment:

Corner established by H.C. Lawrence, Registered Land Surveyor, in 1950. Set 2" x 6" red pine post at 22.00 chains West of S-1/4 corner.

Description of corner evidence found:

Recovered 2" x 6" red pine post, scribed W-1/16 S6, W-1/16 S7 in poor condition. No OBT's visible.

Description of monument and accessories I established to perpetuate the original location of this corner. Replaced 2" x 6" scribed post with 1" O.D. iron pipe with 2" brass cap stamped - Pipe projects 12" above ground.

As this area has been clear-cut, no trees available for BT's. Set 1-1/2" iron pipe with 2" brass cap North 20 lks. for Witness Corner. Brass cap stamped W.C. S 20 lks. Pipe projects 16" above ground. Corner pipe and W.C. painted blue. W-1/16 S 6 S 7 CPI-1975

Dated at Rhinelander, Wis., this 1st day of December, 1975

Signature: Phillip T. Hansen, Title: Registered Land Surveyor, Registration No. S-498 (County Surveyor, Registered Land Surveyor, or other duly authorized official)

Office of Register of Deeds, County of Oneida. I hereby certify that the within instrument was filed in this office for record on the 4th day of December, 1975 at 1:05 o'clock P.M.

Signature: Dennis George Fischer, (Register of Deeds)

By: Deputy

3611060030