


CERTIFIED LAND CORNER RESTORATION

Index No. **5-5**

State of Wisconsin }
 County of Oneida } ss.

I Philip T. Hansen do hereby certify that on the 19th day of March 1975, I found evidence of the Section Corner corner of Sections 7, 8, 17-18 Township 36 North, Range 11 East, Fourth Principal Meridian, as described hereon; and that from this evidence I established a new monument and accessories as described hereon to perpetuate the original location of this corner.

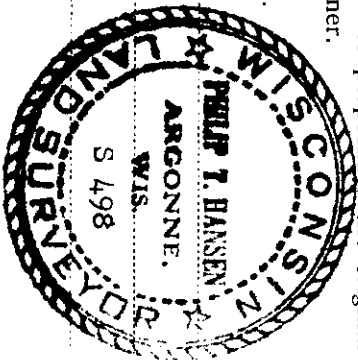

Resident witnesses.

History of original corner establishment:

Original corner established by Wm. E. Dougherty, Gov. Deputy Surveyor, in 1859.
 White pine 14" S18W 63 links
 Sugar 16" N35E 12 links
 H.C. Lawrence, Registered Land Surveyor, re-established the corner in 1951 during his retracement survey. Stump of original white pine, 14", S18°W, 63 links, fir (down) 8", S54°W, 25 links.
 Set 4" cedar post, squared, and scribed S7-S8-S17-S18.

Description of corner evidence found:

Recovered 4" cedar post, squared, and scribed S7, S8, S17-S18. Also a 2 1/2" I.P. w/brass cap not stamped.

No BT's visible.


Description of monument and accessories I established to perpetuate the original location of this corner.

Replaced wooden post with 2 1/2" aluminum pipe with cast aluminum cap stamped -

NBT's -	sugar maple 8"	N13°E	32.2 links	scribed SC BT	
	sugar maple 6"	N47°W	11 links	scribed SC BT	S498
	sugar maple 6"	S82°E	51.2 links	scribed SC BT	T36N R11E

S7	S8
S18	S17

CPI-1975

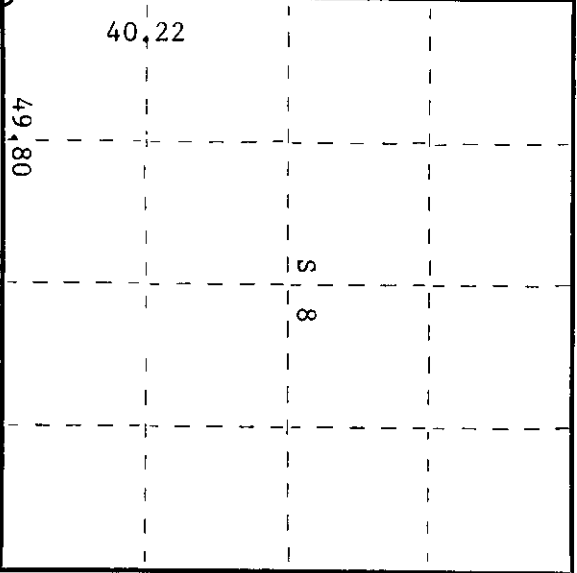

○ = Corner monument restored.

Dated at Rhinelander Wis., this 16th day of June, 1975.

Signature: *Philip T. Hansen* Title: Registered Land Surveyor Registration No. S-498
 (County Surveyor, Registered Land Surveyor, or other duly authorized official)

Office of Register of Deeds, County of Oneida On the 1st day of October 1975
 at 3:00 o'clock P.M. I hereby certify that the within

Tommy Lange Fueten
 (Register of Deeds)

By: Deputy

3611070000