

CERTIFIED LAND CORNER RESTORATION

Index No. H-5

State of Wisconsin

County of Oneida } ss.

I Phillip T. Hansen, do hereby

certify that on the 21st day

of March 19 75, I found

evidence of the S-1/16

corner of Sections 7 and 8

Township 36, North, Range


11 East, Fourth Principal Meridian,

as described hereon; and that from this evidence


I established a new monument and accessories

as described hereon to perpetuate the original

location of this corner.

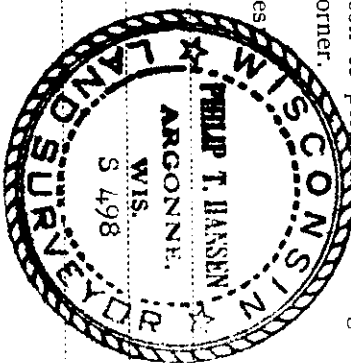

T36N, R11E

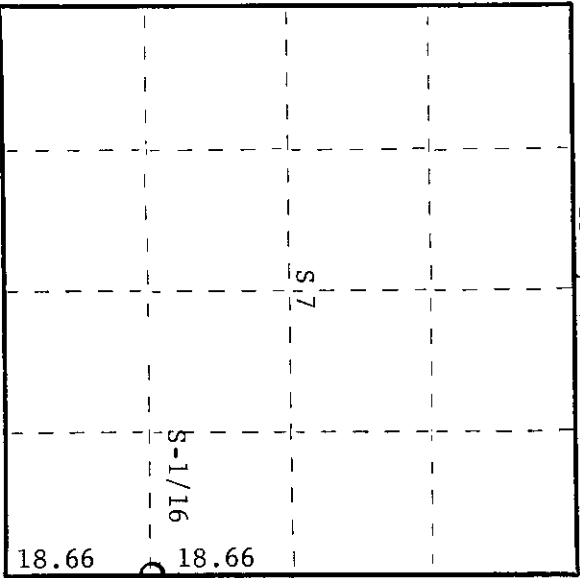

○ = Corner monument restored.

History of original corner establishment:

Corner established by H.C. Lawrence, Registered Land Surveyor, during his retracement survey in 1950. Ran a random line S6°30'W from a point 5 links west of D.H. Vaughan's re-established 1/4 corner, 37.72 chains to a point 64 links east of re-established original corner sections 7-8-17-18. Total departure 69 links east. Corrected bearing of section line S7°34'W.

Set S-1/16 corner, equidistant at 18.66 chains, 37 links west, from which a maple 15" bears N75°W, 41 links.

Description of corner evidence found:

Recovered 3-1/2" cedar post, squared and scribed S-1/16 S7, S-1/16 S8, in fair condition; also a 1-1/2" iron pipe.

Recovered BT sugar maple 15", N75°W, 41 links scribed S-1/16 BT. This tree appears to be dying.

Description of monument and accessories I established to perpetuate the original location of this corner.

Replaced wooden post with 1-1/4" O.D. x 5' galvanized iron pipe with 2" brass cap stamped -

NBT's - Oak 8" S66°E 38 links scribed 1/16 BT S498

Sugar maple 6" S84°W 68 links scribed 1/16 BT T36N, R11E

Corner sets in old logging road. Recovered 1-1/2" pipe set S-1/16 S7 + S8

one foot west of established corner. CPI-1975

Dated at Rhineland, Wis. this 16th day of June, 19 75.

Signature Phillip T. Hansen Title Registered Land Surveyor Registration No. S-498  
(County Surveyor, Registered Land Surveyor, or other duly authorized official)

Office of Register of Deeds, County of Oneida, I hereby certify that the within instrument was filed in this office for record on the 1st day of October, 19 75 at 3:00 o'clock P. M.

Dennis Tenney (Register of Deeds)

By Dennis Tenney Deputy

By \_\_\_\_\_ Deputy

3611071000