

CERTIFIED LAND CORNER RESTORATION

Index No. **G-4**

State of Wisconsin

County of Oneida } ss.

I Phillip T. Hansen, do hereby

certify that on the 15th day

of December, 1978, I found

evidence of the EC 1/16

corner of the Section 7

Township 36, North, Range


11 East, Fourth Principal Meridian,

as described hereon; and that from this evidence

I established a new monument and accessories

as described hereon to perpetuate the original

location of this corner.

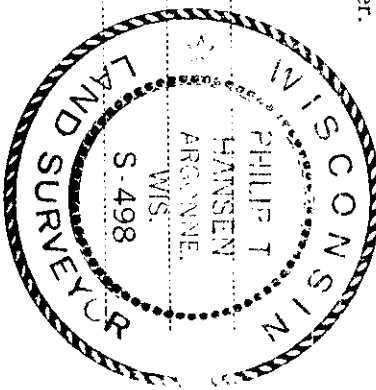


Resident witnesses:

Glen Barker

Jim Clafflin

Herb Wagoner

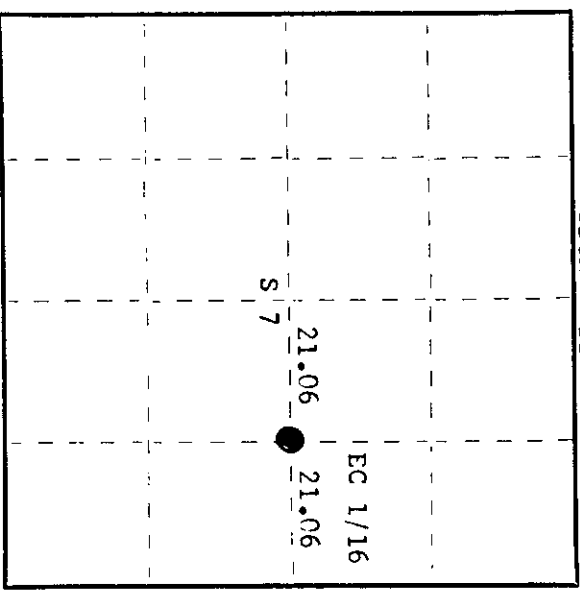

History of original corner establishment:

Corner established by H.C. Lawrence, Registered Land Surveyor, in 1950. From B.F. Dorr's C 1/4 corner, which he had recovered, he ran S 89° 45' E 42.12 chains to close out on link south of Vaughan's 1/4 post. Set EC 1/16 at 21.06 chains equidistant. No trees for BT's.

Description of corner evidence found:

Recovered H.C. Lawrence's 5" squared cedar post, scribed EC 1/16 S7 in poor condition but still standing. No evidence of any BT's recovered.

Description of monument and accessories I established to perpetuate the original location of this corner.

Replaced 5" cedar post with 1" iron pipe with 2" brass cap.  
Projects 1 1/2' above ground - stamped:  
Marked NBT's - Sugar 8" S62°W 32.2 links  
Maple 8" S59°E 14.9 links  
both scribed 1/16 BT  
S498  
T36N R11E  
EC 1/16 S7  
CPI-1978

Dated at Rhinelander, Wis., this 11th day of December, 1978

Signature Phillip T. Hansen Title Registered Land Surveyor Registration No. S-498  
(County Surveyor, Registered Land Surveyor, or other duly authorized official)

Office of Register of Deeds, County of Oneida  
at 100 o'clock P. M. 18th day of December, 1979  
Donna Weirage, Register  
(Register of Deeds)

By: \_\_\_\_\_ Deputy

3611072010