



CERTIFIED LAND CORNER RESTORATION

Index No. **J-9**

State of Wisconsin }  
 County of Oneida } ss.

I, Phillip T. Hansen, do hereby certify that on the 27th day of February, 1975, I found evidence of the Section Corner corner of Sections 8-9-16-17 Township 36 North, Range 11 East, Fourth Principal Meridian, as described hereon; and that from this evidence I established a new monument and accessories as described hereon to perpetuate the original location of this corner.

Resident witnesses:

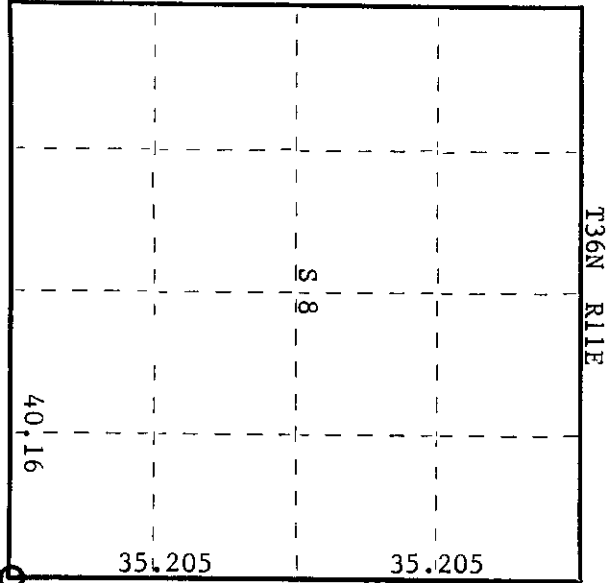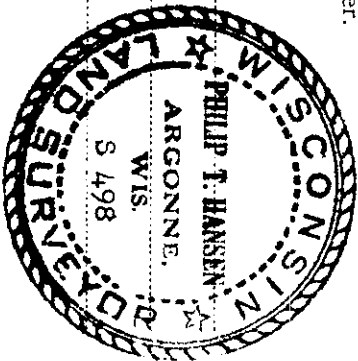

○ = Corner monument restored.

History of original corner establishment:  
 Original corner established by Wm. E. Dougherty, Gov. Deputy Surveyor, in 1859.

Recovered by B.F. Dorr, County Surveyor, in 1898. Set new BTs, white pine 12", N57½E, 29 links; balsam 8", S54W, 25 links. Used by D.H. Vaughan, County Surveyor in his survey of 1904. Recovered by H.C. Lawrence, Reg. Land Surveyor, in his retracement survey of 1936. He set new cedar post and made NBTs - viz - sugar maple 10", N50W, 8½ links; white birch 3", S54W, 25 links; hemlock 14", S43W, 59 links.

Description of corner evidence found:

Recovered 4" cedar post, squared, and scribed S8, S9, S16, S17, in good condition.  
 Recovered BTs sugar maple 10" N50W 8½ links scribed SB  
 white birch 3" S54W 233 links scribed BT

Description of monument and accessories I established to perpetuate the original location of this corner.  
 Replaced cedar stake with 2½" x 5" galvanized iron pipe w/brass cap, stamped -

NBTs - white birch 6" N85E 30.6 links scribed SC BT

S498	
T36N	R11E
S8	S9
S17	S16

Dated at Rhinelander, Wis., this 10th day of June, 1975.

Signature *Phillip T. Hansen* Title Registered Land Surveyor Registration No. S-498  
 (County Surveyor, Registered Land Surveyor, or other duly authorized official)

Office of Register of Deeds, County of Oneida. On this 1st day of October, 1975, I hereby certify that the within instrument was filed in this office for record on the 300 o'clock M.

*Dorai Verage Fisher*  
 (Register of Deeds)

By: Deputy

3611080000