


CERTIFIED LAND CORNER RESTORATION


Index No. **J-8**

State of Wisconsin }
 County of Oneida } ss.

I Phillip T. Hansen, do hereby certify that on the 27th day of February, 1975, I found evidence of the E-1/16 corner of Sections 8 and 17 Township 36 North, Range 11 East, Fourth Principal Meridian, as described hereon; and that from this evidence I established a new monument and accessories as described hereon to perpetuate the original location of this corner.

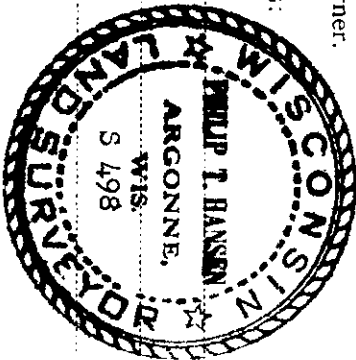

Resident witnesses:

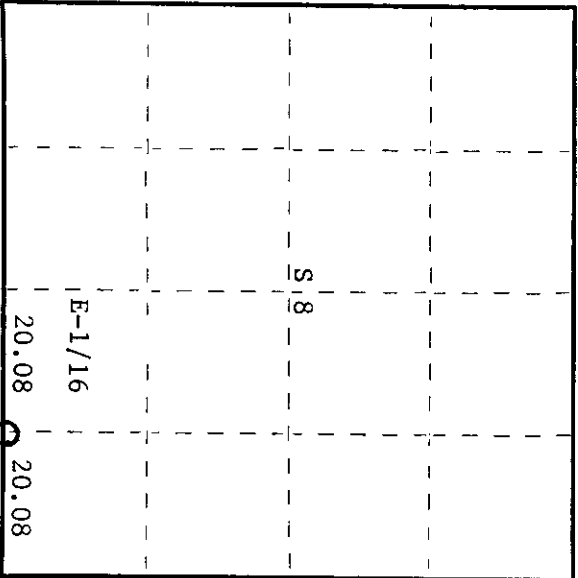

○ = Corner monument restored.

History of original corner establishment:

Corner established by H.C. Lawrence, Reg. Land Surveyor, during his retracement survey in 1946.
 From the 1/4 corner between Sections 8 and 17, which, according to D.H. Vaughan, was set from original bearing trees in 1904, Lawrence ran N85°E, 40.16 chains to intersect the corner of 8-9-16-17.
 He set the E-1/16 corner at 20.08 chains from which his bearing trees - hemlock 16" bears S26½E, 13½ links and hemlock 12" bears N39½W, 28½ links.

Description of corner evidence found:

Recovered H.C. Lawrence's 4" cedar post, squared, and scribed S8 E-1/16; S17 in poor condition.
 Recovered BT - hemlock 16" S26½E 13½ links, now a stump. No scribing visible.
 hemlock 12" N39½W 28½ links, now rotten stump. No scribing visible.

Description of monument and accessories I established to perpetuate the original location of this corner.

Replaced wooden stake with 1½" OD x 5' iron pipe w/2" brass cap, stamped -
 NBTs - hemlock 18" N87°E 89 links scribed 1/16 BT
 white spruce 6" N86°W 70.8 links scribed 1/16 BT

S498
 T36N R11E

E-1/16 S|8
 S|I7
 CPI-1975

Dated at Rhineland, Wis., this 10th day of June, 1975.

Signature: *Phillip T. Hansen* Title: Registered Land Surveyor Registration No. S-498
 (County Surveyor, Registered Land Surveyor, or other duly authorized official)

Office of Register of Deeds, County of Oneida. I hereby certify that the within instrument was filed in this office for record on the 1st day of October, 1975 at 3:00 o'clock P.M.

Donna Vennergeer
 (Register of Deeds)

By: Deputy