


CERTIFIED LAND CORNER RESTORATION

Index No. H-7

State of Wisconsin


County of Oneida } ss.

I Philip T. Hansen, do hereby certify that on the 12th day of March, 1975, I found evidence of the SC-1/16 corner of Section 8 Township 36 North, Range 11 East, Fourth Principal Meridian, as described hereon; and that from this evidence I established a new monument and accessories as described hereon to perpetuate the original location of this corner.

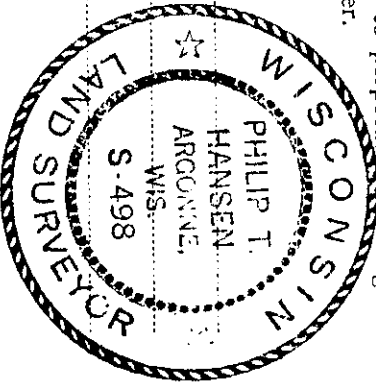

Resident witnesses:

T36N R11E

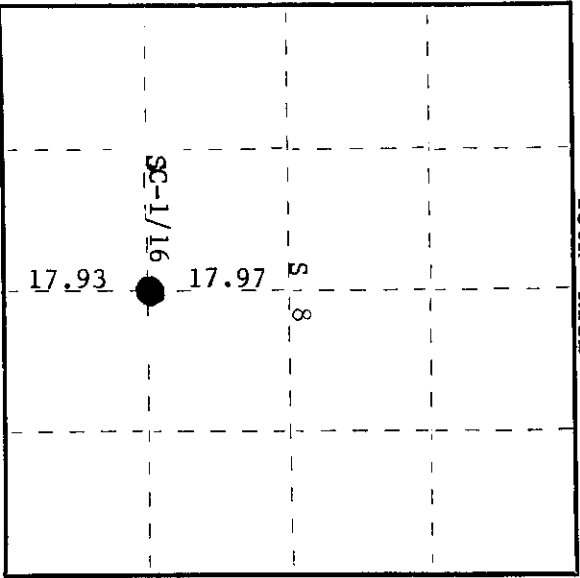

○ = Corner monument restored.

History of original corner establishment:

Original corner established by D.H. Vaughan, County Surveyor, in 1904. Corner recovered by H.C. Lawrence, Reg. Land Surveyor, in 1936 while running from the recovered C-1/4 corner South 5°00' West to the 1/4 corner between Sections 8 and 17, 35.90 chains to a point 160 links East of 1/4 corner at right angles. Corrected bearing S7°32'W. Set new post at SC-1/16 in place of old one from which hemlock stump 10" bears N30°W, 22½ links and hemlock 7" bears S90E, 24 links.

New BT - yellow birch 14" S63°E 22½ links.

Description of corner evidence found:

Recovered H.C. Lawrence's 5" cedar post, squared, and scribed S8 SC-1/16 in fair condition. Also found 4" cedar post, squared, setting beside it.

Recovered hemlock 7" S90E 24 links now 15" scribed but grown over.

yellow birch 14" S63°E 22½ links scribed SC-1/16 S8 BT, now a dead stub. No sign of old hemlock stump.

Description of monument and accessories I established to perpetuate the original location of this corner.
Replaced Lawrence's 5" cedar post with 1-1/4" OD x 5' galvanized iron pipe w/2" brass cap, stamped -

NBT sugar maple 8" N72°E 38 links scribed 1/16 BT T36N R11E

S498
SC-1/16 — S | 8
CPI-1975

Dated at Rhineland, Wis. this 16th day of June, 1975.

Signature Philip T. Hansen Title Registered Land Surveyor Registration No. S-498
(County Surveyor, Registered Land Surveyor, or other duly authorized official)

Office of Register of Deeds, County of Oneida, I hereby certify that the within instrument was filed in this office for record on the 1st day of October, 1975 at 3:00 o'clock P. M.

Donna Terence Fisher
(Register of Deeds)

By _____ Deputy