

CERTIFIED LAND CORNER RESTORATION


Index No. **G-9**

State of Wisconsin


County of Oneida } ss.

I Phillip T. Hansen do hereby certify that on the 8th day of January, 1975, I found evidence of the 1/4 corner of Sections 8 and 9 Township 36, North, Range 11 East, Fourth Principal Meridian, as described hereon; and that from this evidence I established a new monument and accessories as described hereon to perpetuate the original location of this corner.

Resident witnesses:

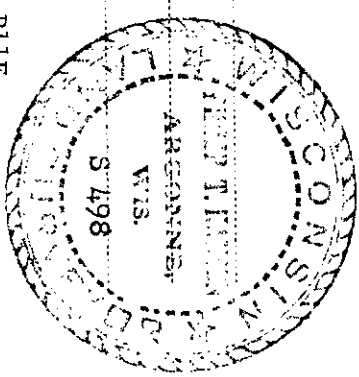

T36N, R11E

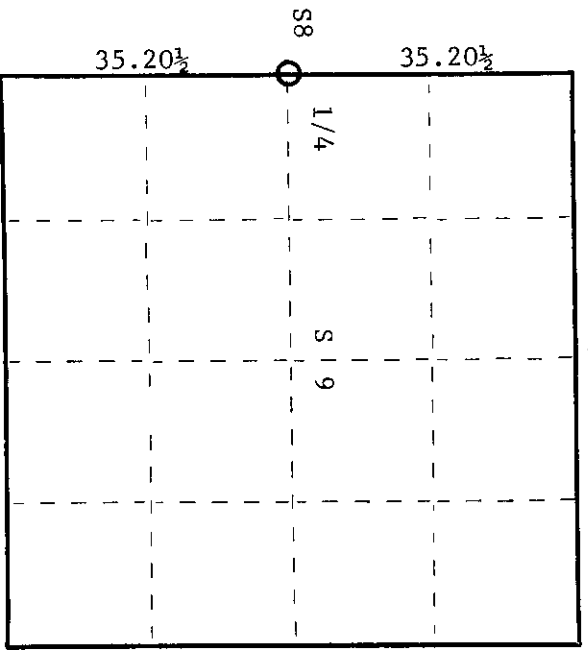

○ = Corner monument restored.

History of original corner establishment:
Original corner set by Wm. E. Dougherty, Gov't Deputy Surveyor in 1859.

Recovered and remarked by B.F. Dorr in 1898. Set new BT's, white pine 12", N57 1/2 E, 29 lks. Balsam 8", S54W, 25 lks. Corner was recovered by D.H. Vaughan, County Surveyor in 1904. H.C. Lawrence, Reg. Land Surveyor, recovered corner and the white pine stump in 1936. He set a new cedar post and established NBT's.

Sugar maple 10" N50W 8 1/2 lks.
White birch 3" S54W 25 lks.
Hemlock 14" S43W 59 lks.

Description of corner evidence found:
Recovered 4" cedar post, squared and scribed S8-1/4, S9-1/4 in fair condition.
No trace of bearing trees visible.

Description of monument and accessories I established to perpetuate the original location of this corner.
Set new 2-1/2" x 5' galvanized iron pipe with brass cap stamped -

New BT's	Black spruce 8"	S18°E	20 lks.	scribed 1/4 BT	T36N, R11E
	Black spruce 8"	S68W	39 lks.	scribed 1/4 BT	S498

S8: S9
1/4
CPT-1975

Dated at Rhineland, Wis., this 16th day of June, 1975.

Signature Phillip T. Hansen Title Registered Land Surveyor Registration No. S-498
(County Surveyor, Registered Land Surveyor, or other duly authorized official)

Office of Register of Deeds, County of Oneida I hereby certify that the within instrument was filed in this office for record on the 1st day of October, 1975 at 3:00 o'clock P. M.

Doris Savage Kuehn
(Register of Deeds)

By _____ Deputy

3611082000