

CERTIFIED LAND CORNER RESTORATION



Index No. **Q-8**

State of Wisconsin

County of Oneida } ss.

I Philip T. Hansen do hereby certify that on the 12th day of March 19 75, I found evidence of the EC-1/16 corner of Section 8 Township 36 North, Range 11 East, Fourth Principal Meridian, as described hereon; and that from this evidence I established a new monument and accessories as described hereon to perpetuate the original location of this corner.

Resident witnesses:

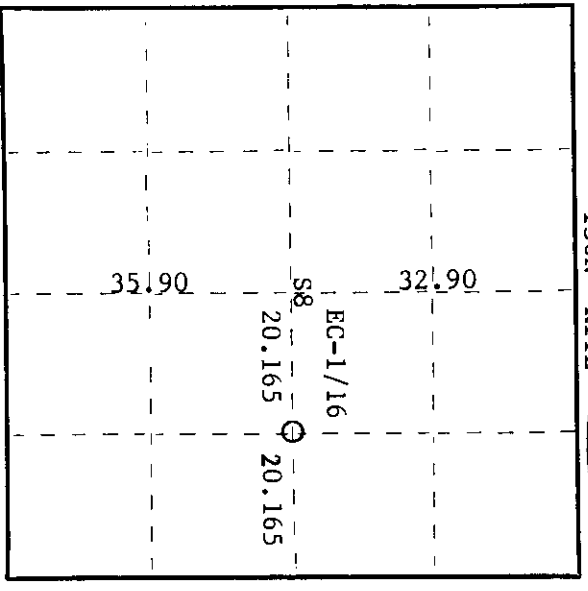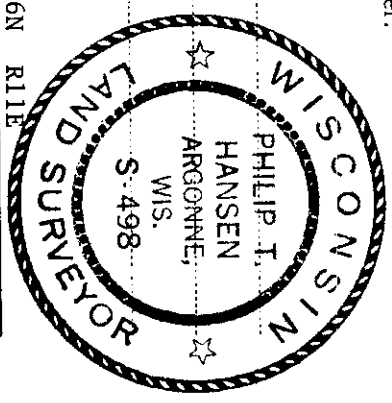

○ = Corner monument restored.

History of original corner establishment:

Corner established by H.C. Lawrence, Reg. Land Surveyor, in 1936 during his subdivision of Section 8. He ran S87°00'W from his temporary 1/4 post, between Sections 8 and 9, 40.25 chains to intersect D.H. Vaughan's C-1/4 at a point 12 links north. As Vaughan's chainage from the C-1/4 corner to 1/4 corner between Sections 8 and 9 was 40.33 chains, he moved his temporary corner 8 links east to establish his 1/4 corner between Sections 8 and 9. He established the EC-1/16 post, a 4" cedar post, 6 links south of random line at right angles, equidistant chainage at 20.16 1/2 chains. Corrected line S86°50'W. BTs - white pine 20" N65°W 48 links hemlock 10" S49E 18 links

Description of corner evidence found:

Recovered H.C. Lawrence's 4" cedar post, squared, and scribed EC-1/16 S8 in poor condition.
 Recovered - white pine 20" N65°W 48 links now a rotten stump, scribed EC-1/16 hemlock 10" S49E 18 links now 13" D, scribed EC-1/16

Description of monument and accessories I established to perpetuate the original location of this corner.

Replaced 4" cedar post with 1-1/4" OD x 5' galvanized iron pipe w/2" brass cap, stamped - NBT white birch 8" N79°W 41.3 links scribed 1/16 BT

S498
T36N R11E
EC-1/16 S 8
CPI-1975

Dated at Rhineland, Wis., this 1st day of October, 19 75.

Signature Philip T. Hansen Title Registered Land Surveyor Registration No. S-498
 (County Surveyor, Registered Land Surveyor, or other duly authorized official)

Office of Register of Deeds, County of Oneida I hereby certify that the within instrument was filed in this office for record on the 1st day of October, 19 75 at 3:00 o'clock P. M.

Dennis George Tucker
 (Register of Deeds)

By Dennis George Tucker Deputy